SECTION

TOWNSHIP 34S, RANGE 1W, W. M.

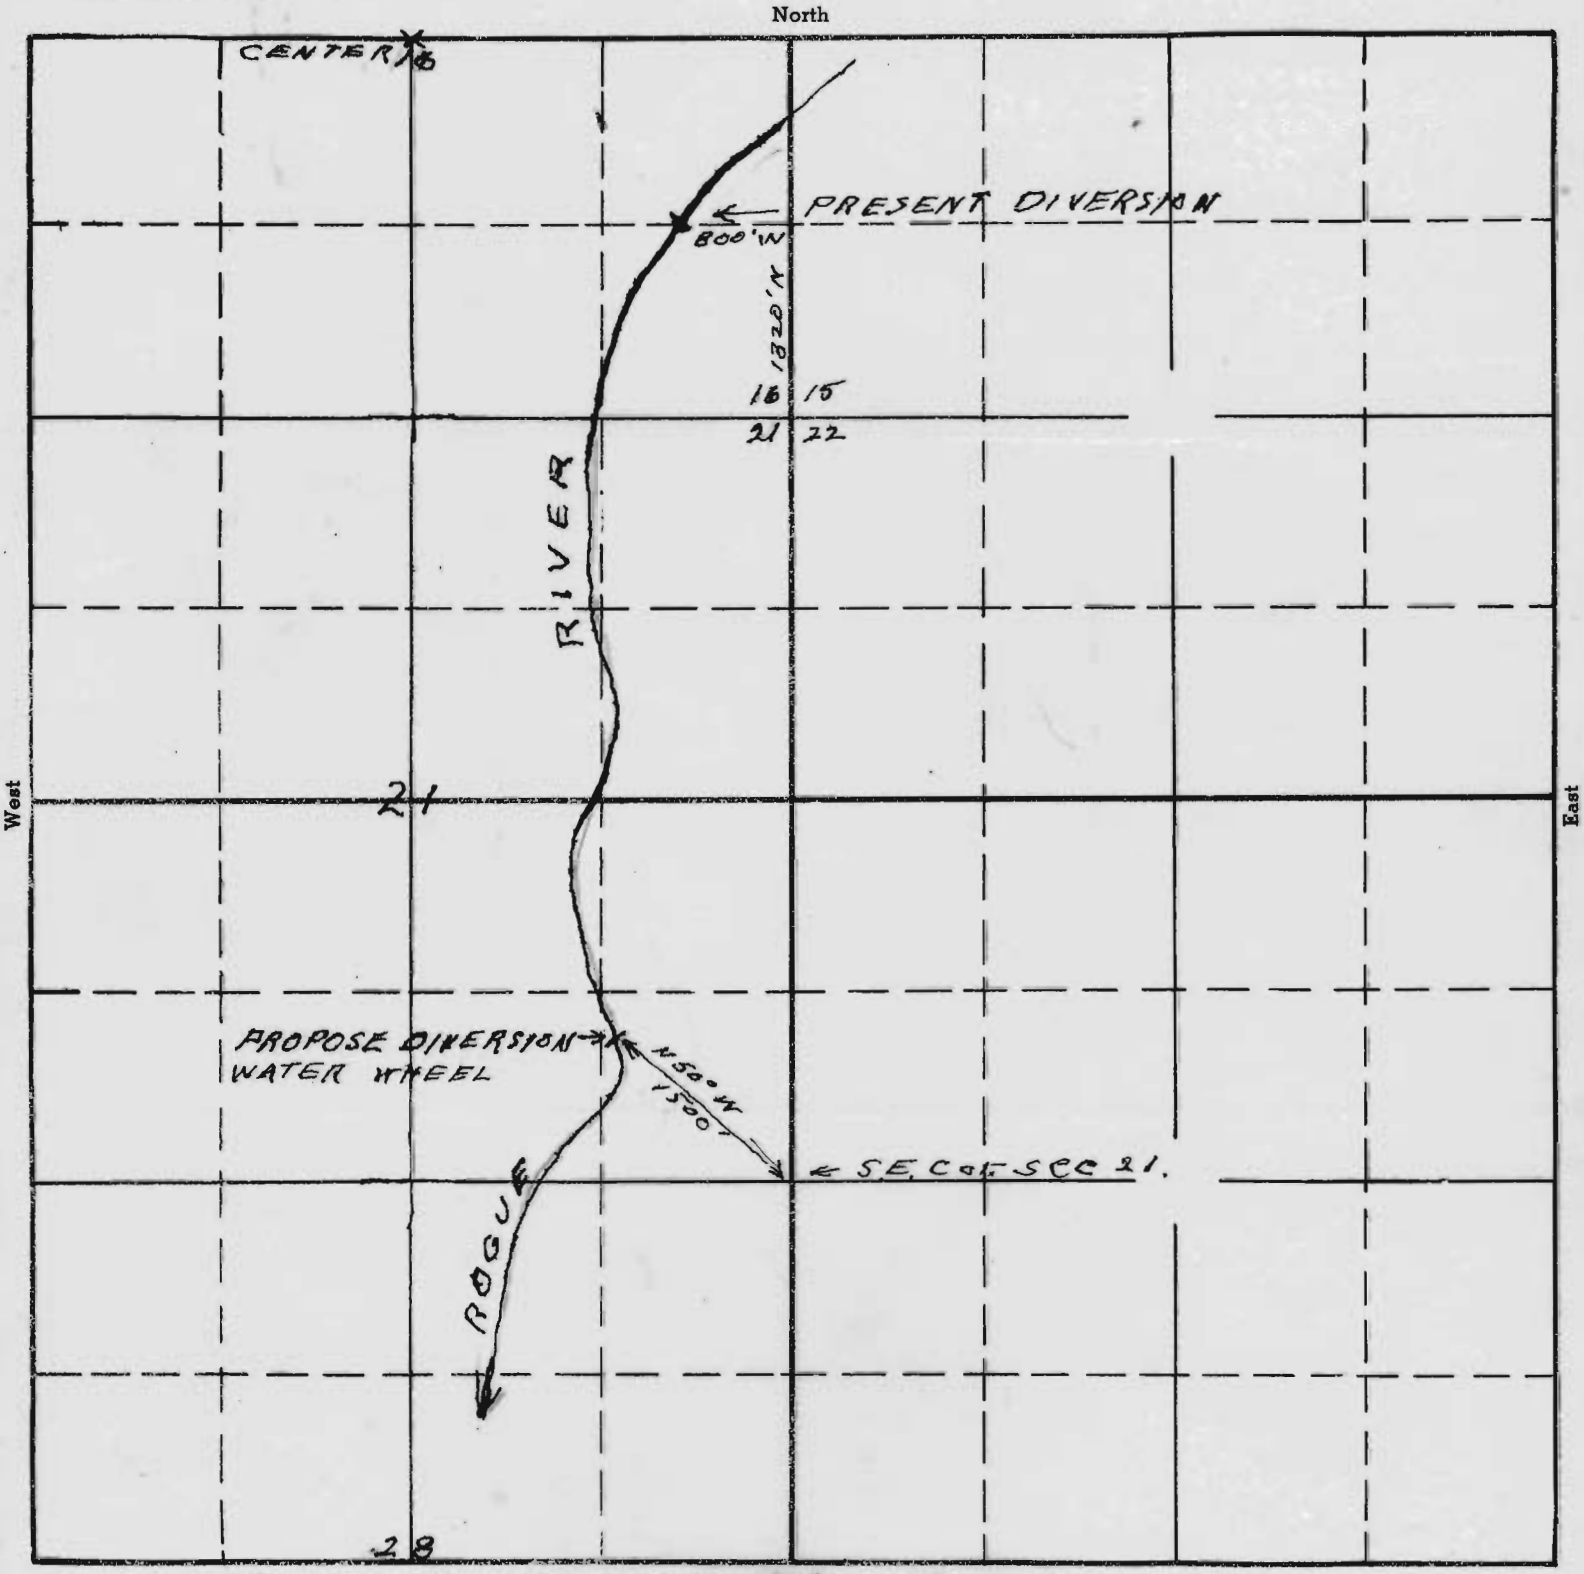

Sketch To accompany application of Wm S and Kenneth De Haas for change in point of diversion.

APPLICATION No.

PERMIT No.

Received Mar 31, 41

D-16

This office 3/28/41