


# T. 5 S. R. 1 E. W. M.

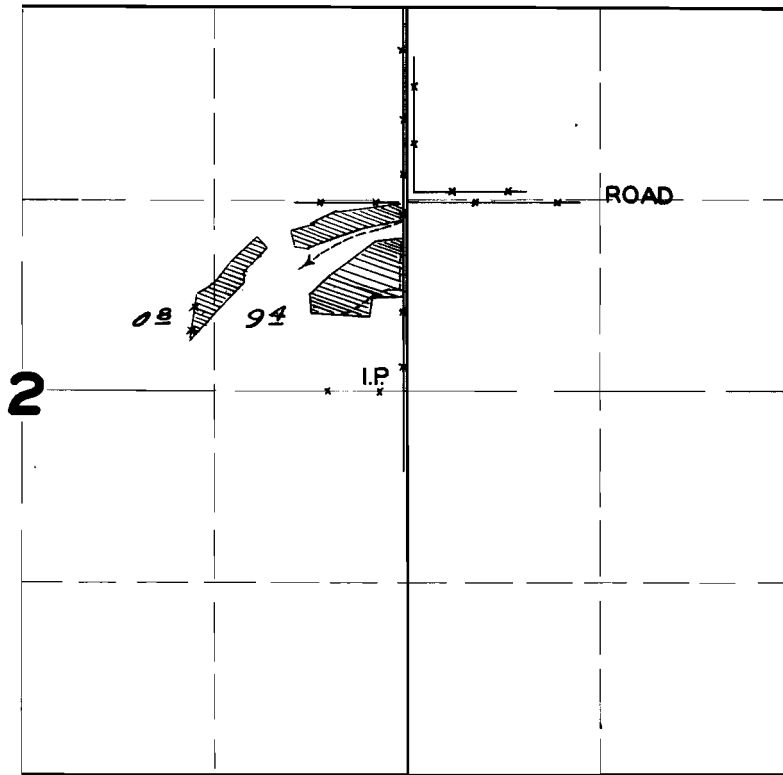

## FINAL PROOF SURVEY

UNDER

TRANSFER D\_40

IN NAME OF

E. S. DISBROW

Surveyed JUL. 11. 1950., by H.L. COFFMAN.