


T. 5 S. R. 12 E. W. M.

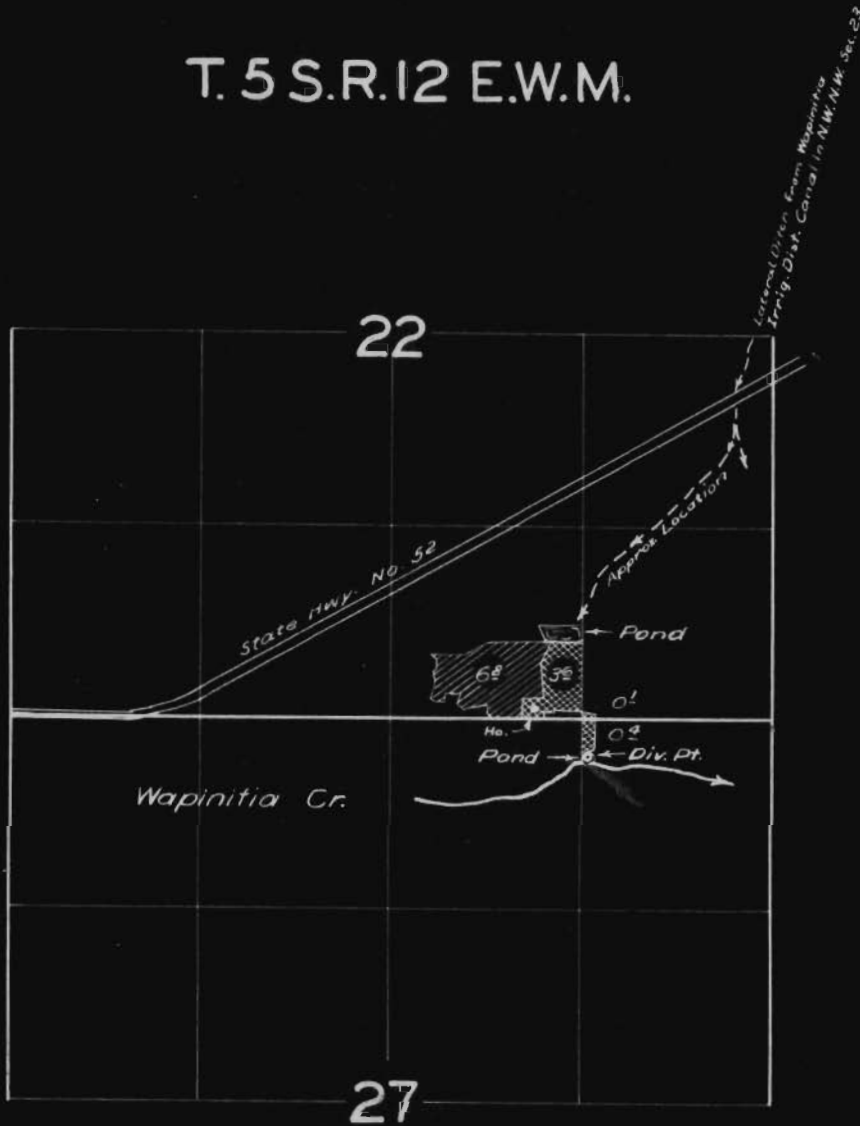

**FINAL PROOF SURVEY**  
UNDER

Transfer No. D-73  
Application No. 30216 Permit No. 23966  
IN NAME OF

HAROLD L. DYKE & LOIS B. DYKE

Surveyed Nov. 16 1959, by T. B. Bish