


T.17S. R.12E.W.M.

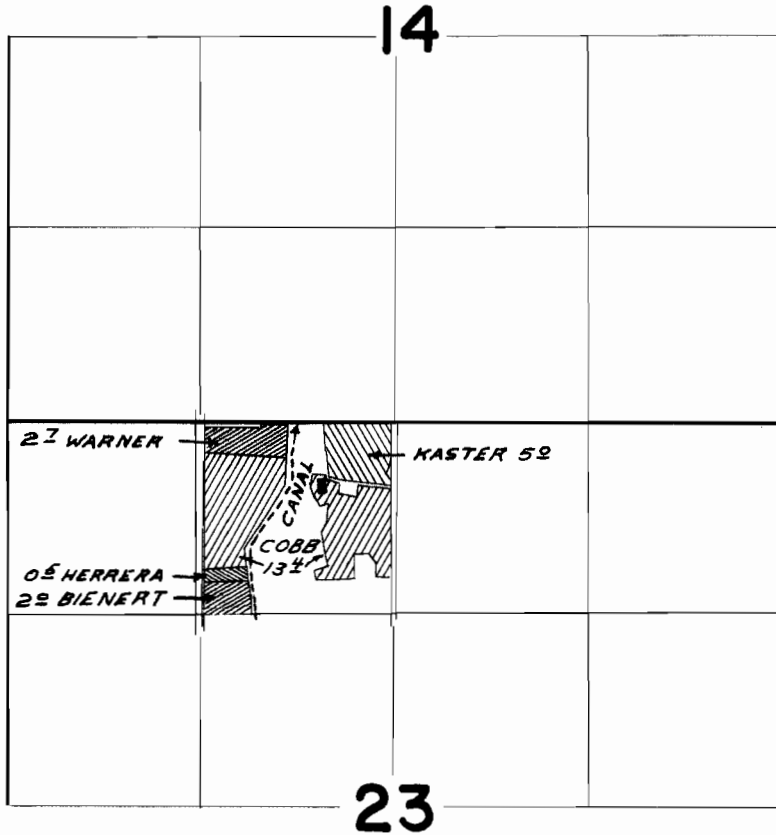


FINAL PROOF SURVEY
UNDER

Transfer D-85

Application No. Permit No.
IN NAME OF

.....
Surveyed *May 3, 1966*, by *W.J. Ruppert*.

T.17S.R.12E.W.M.

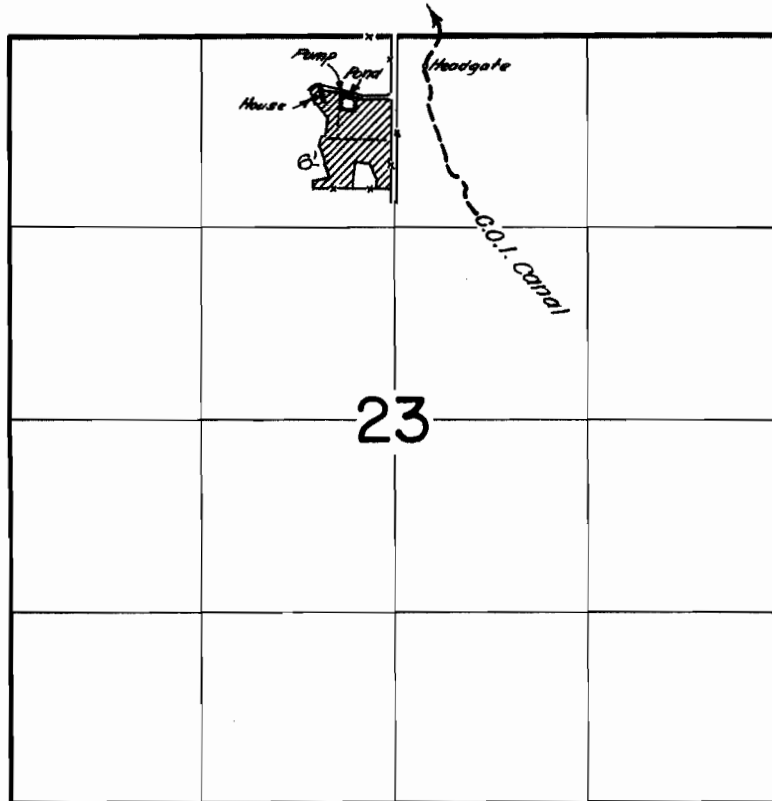

FINAL PROOF SURVEY
UNDER

Transfer No. D-85


Application No. Permit No.

IN NAME OF

MRS. E. C. COBB

Surveyed August 27 1965, by *A. Jackson*

T.17S.R.12&13E.W.M.

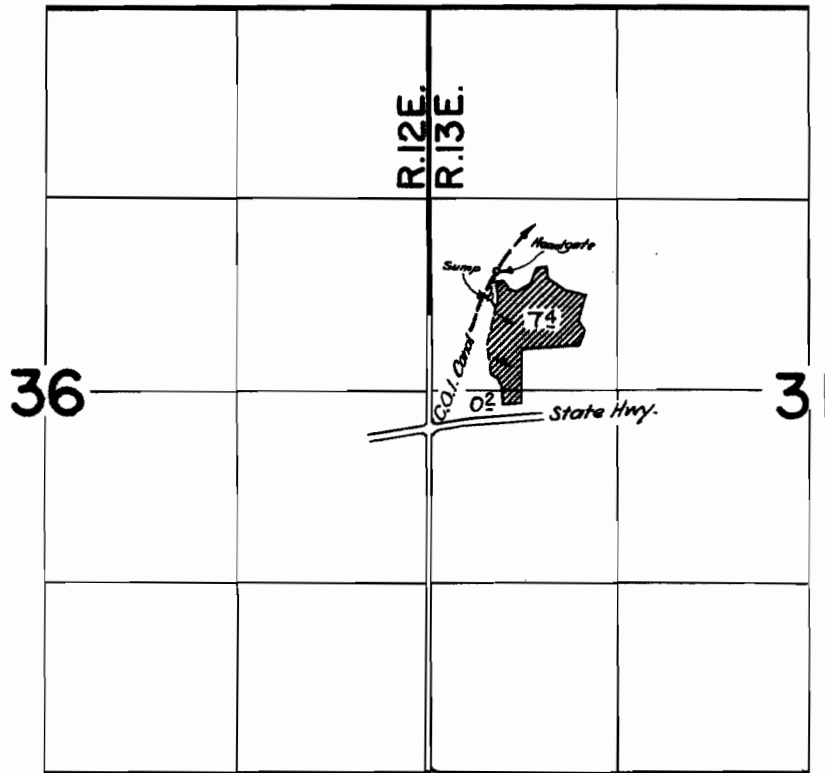

FINAL PROOF SURVEY
UNDER

Transfer No. D-85

Application No. Permit No.

IN NAME OF

VARNEL M. COLE

Surveyed August 13, 1965, by *R. Jackson*