


T.17S.R.12E.W.M.

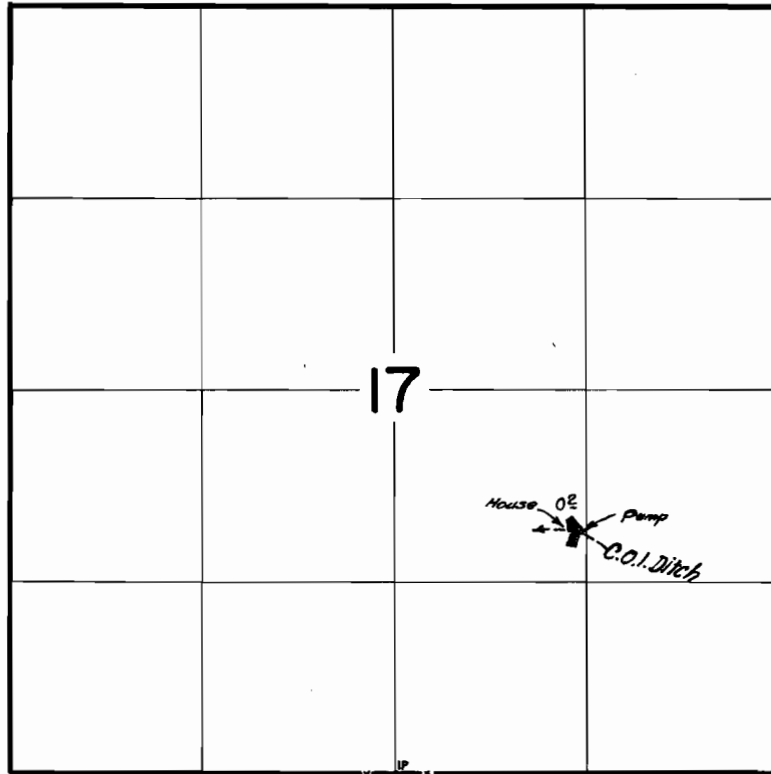

**FINAL PROOF SURVEY**  
UNDER

Transfer No. D-89

Application No. \_\_\_\_\_ Permit No. \_\_\_\_\_  
IN NAME OF

G. J. NEHODA

Surveyed August 11 1965, by *R. Jackson*