


T.17S.R.12E.W.M.

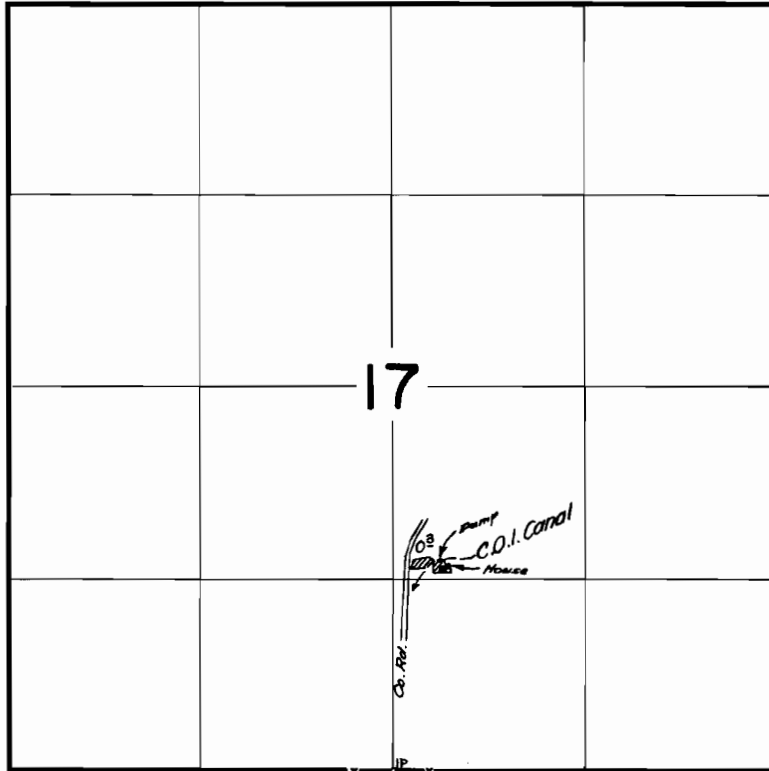

FINAL PROOF SURVEY
UNDER

Transfer No. D-90

Application No. _____ Permit No. _____

IN NAME OF

JACK DE FOE

Surveyed *August 11, 1965*, by *R. H. Jackson*