


TOWNSHIP 34 S., RANGE 1-W., W. M.

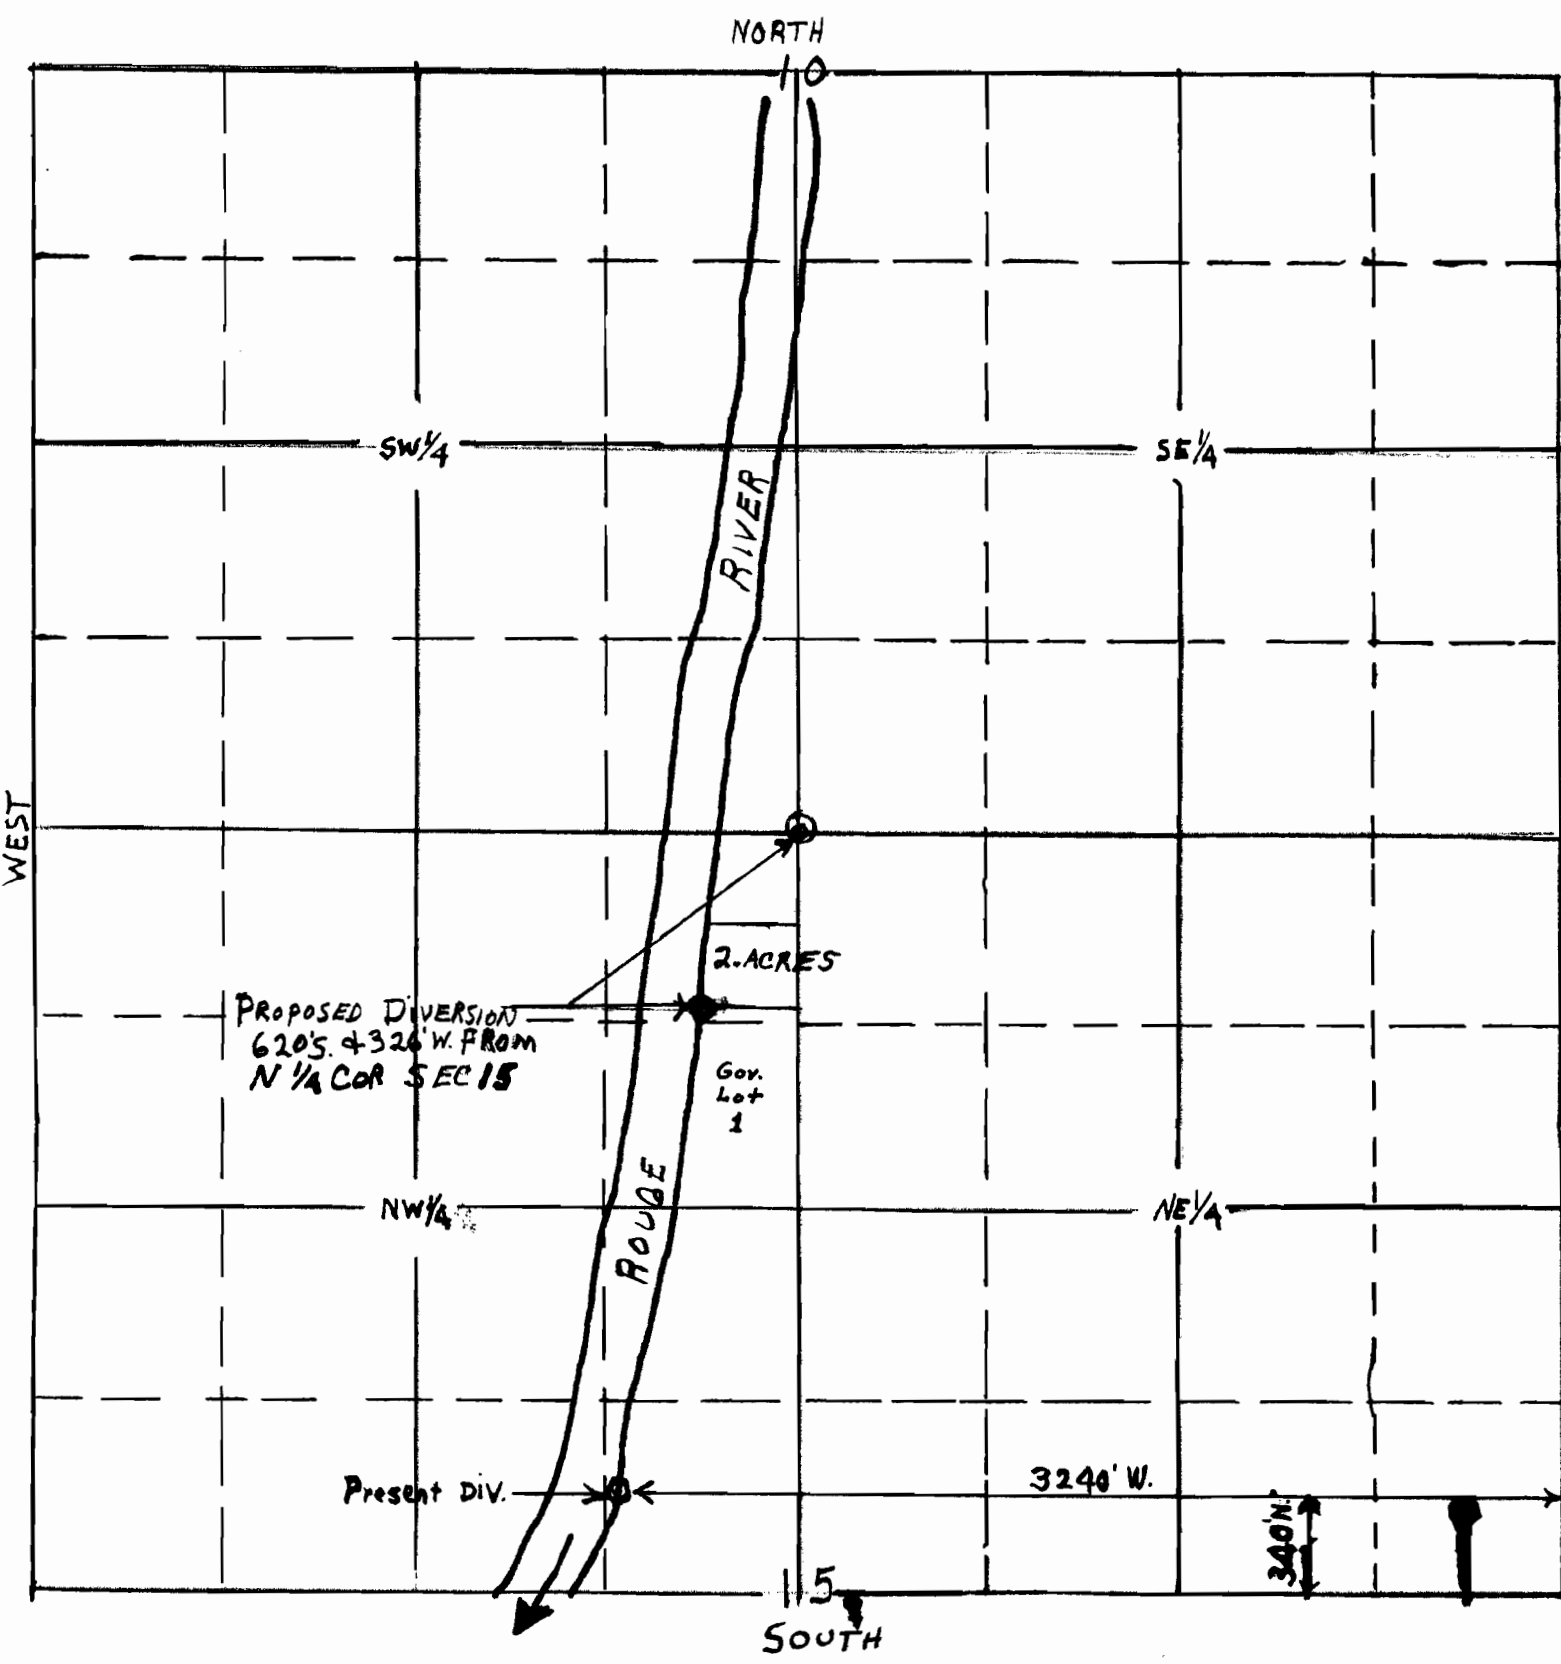

John J. & Louella E. Dickenson

Scale: 8" = 1 mile

2-19-62