


T.17S.R.12E.W.M.

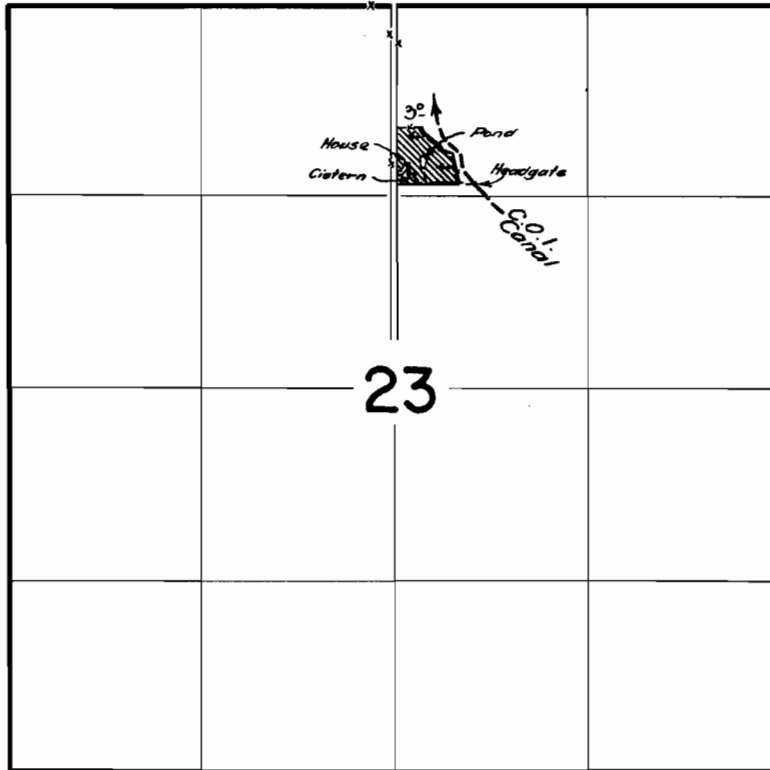

**FINAL PROOF SURVEY**  
UNDER

Transfer No. D-94

Application No. \_\_\_\_\_ Permit No. \_\_\_\_\_  
IN NAME OF

**STANLEY TORNBOM**

Surveyed *August 31, 1965*, by *R. Jackson*