


T. 14 S. R. 39 E. W.M.

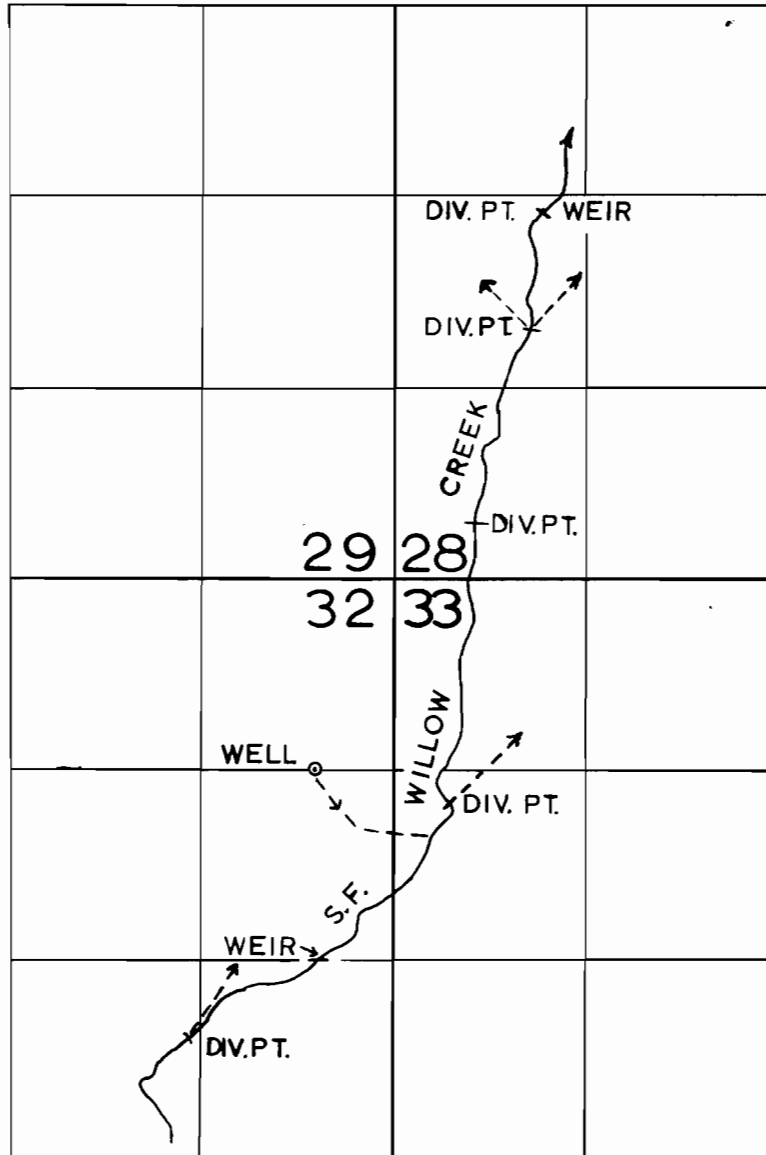

FINAL PROOF SURVEY
UNDER

TRANSFER NO. D-95

Application No. Permit No.
IN NAME OF

RAY DUNCAN

Surveyed SEPT. 15, 1965., by *F.W. Elfving*