
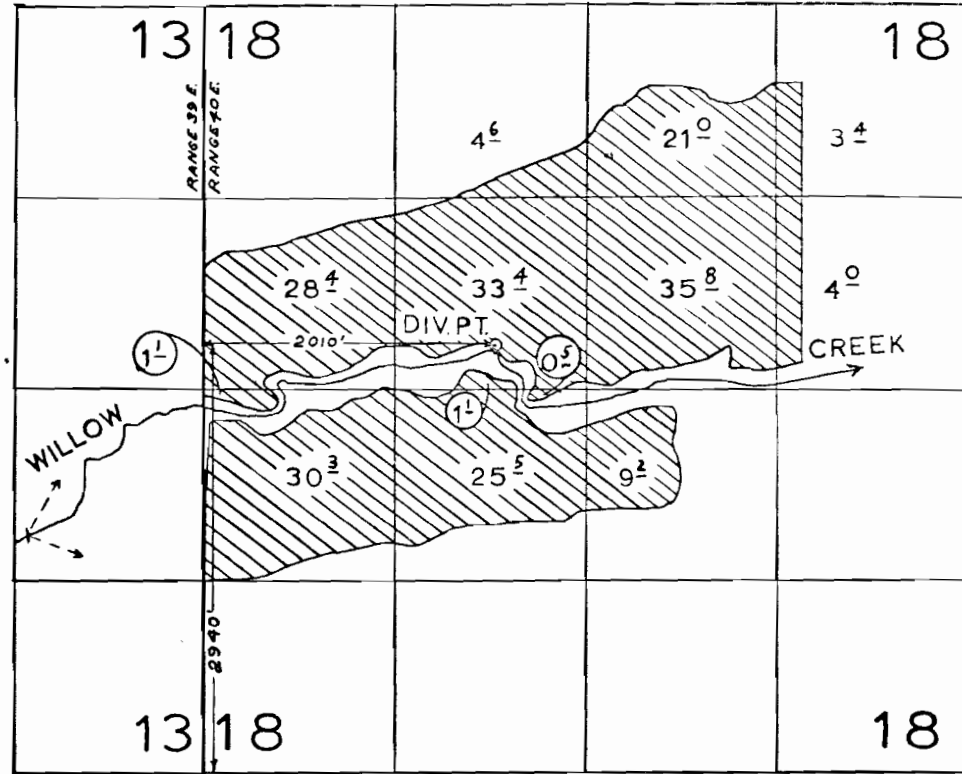


T. 14 S. R. 39 E. 40 E. W. 1 M.

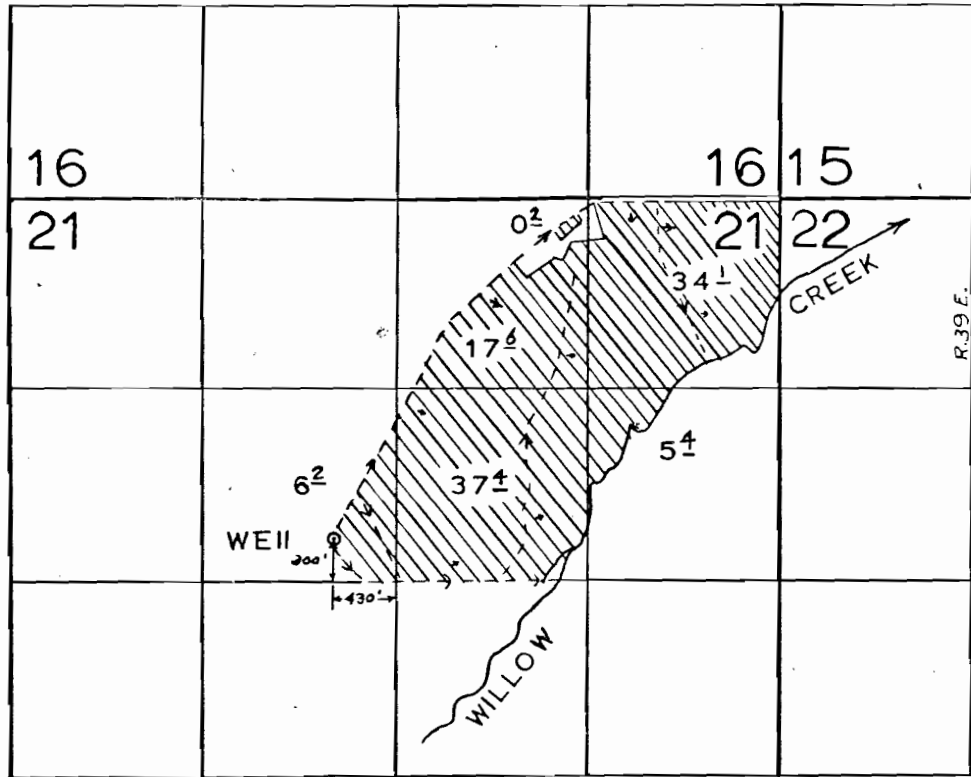

FINAL PROOF SURVEY

UNDER

APPLICATION NO. G-2320

TRANSFER NO. D-99

PERMIT NO. G-2146

IN NAME OF

DUNCAN AND OAKES

SURVEYED NOV. 3 & 4, 1965

BY *Frank W. King*