


T. 5 N. R. 35 E. W. M.

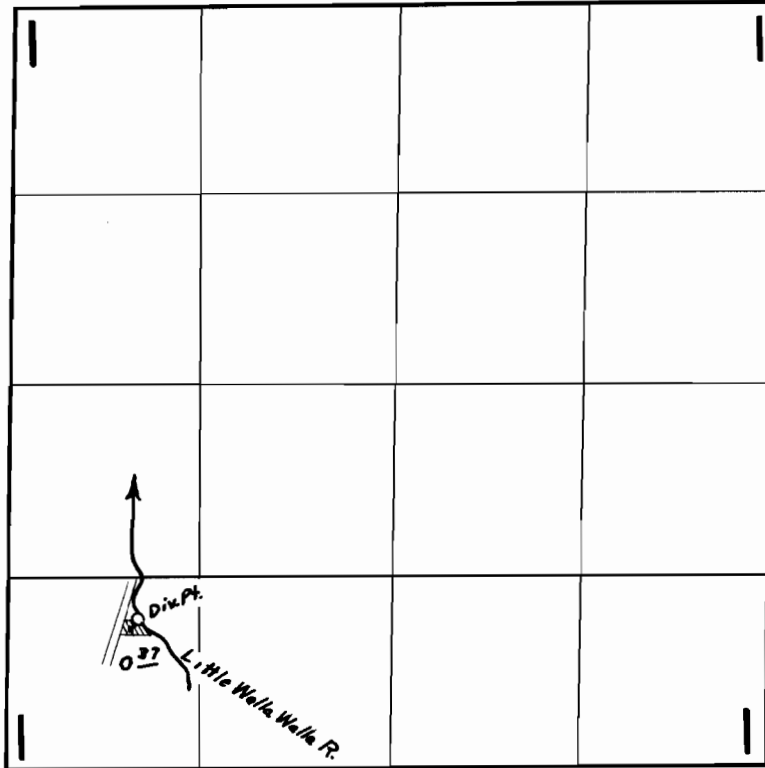

FINAL PROOF SURVEY
UNDER

Transfer No. D-100

Application No. Permit No.

IN NAME OF

STILLMAN & WINNIE C. DEMPSEY

Surveyed April 21, 1964, by R. Jackson