


T. 16 S. R. 14 E. W. M. .

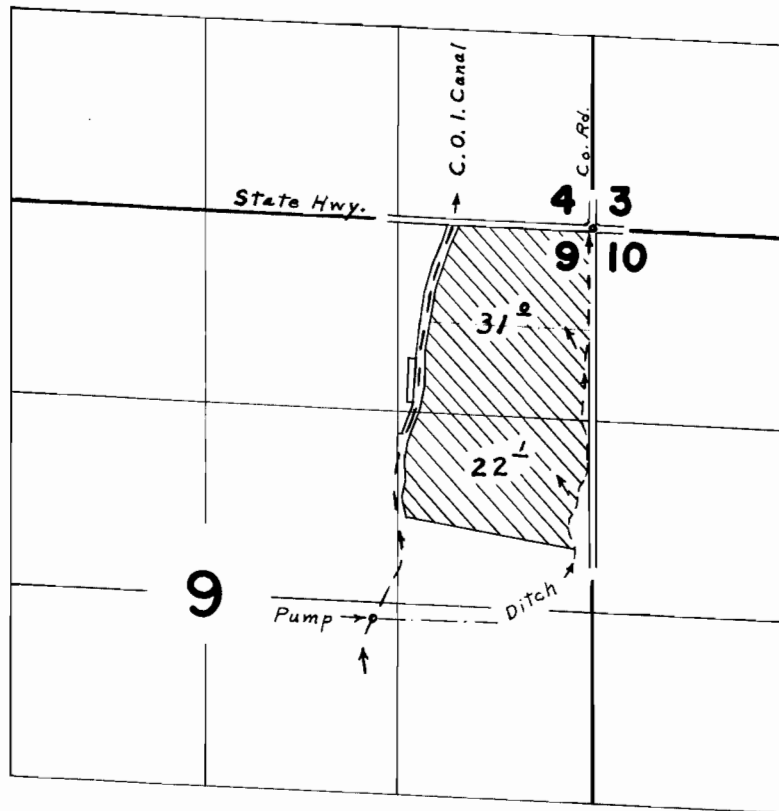

**FINAL PROOF SURVEY**  
UNDER

TRANSFER NO. D-106  
Application No. .... Permit No. ....  
IN NAME OF  
**R. W. McCASLAND**

Surveyed Oct. 23, 1968, by W. J. Ruppert