
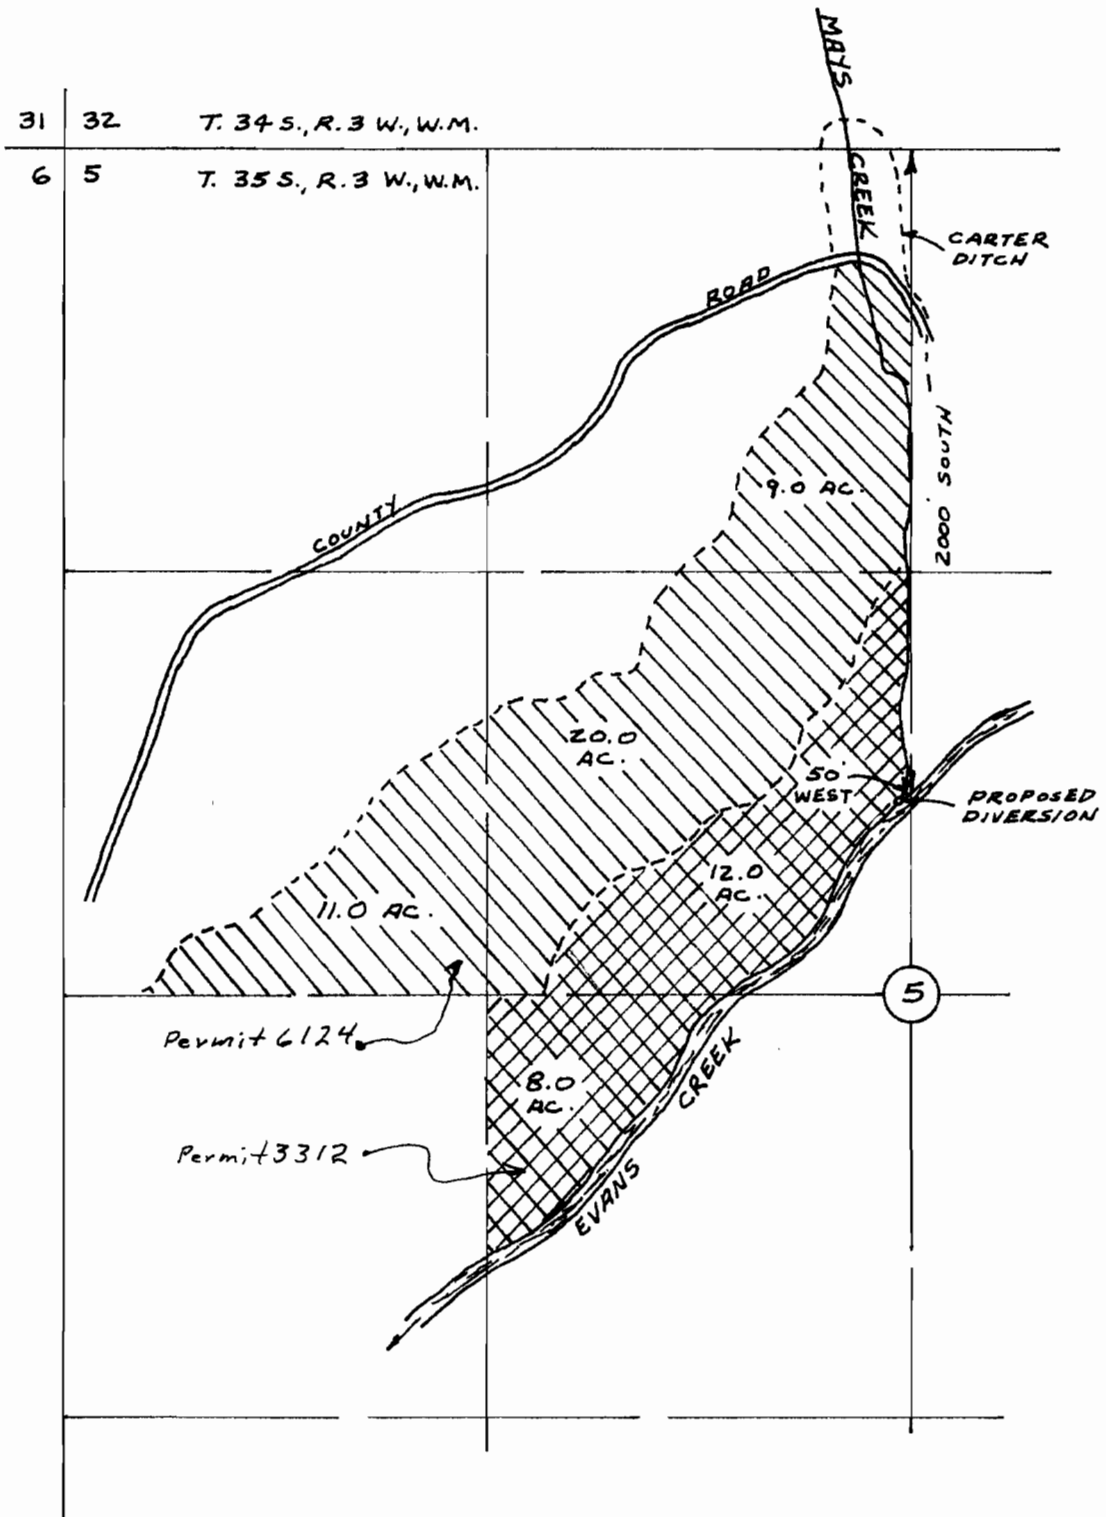


SEC. 34, T. 34 S., R. 3 W., W.M.

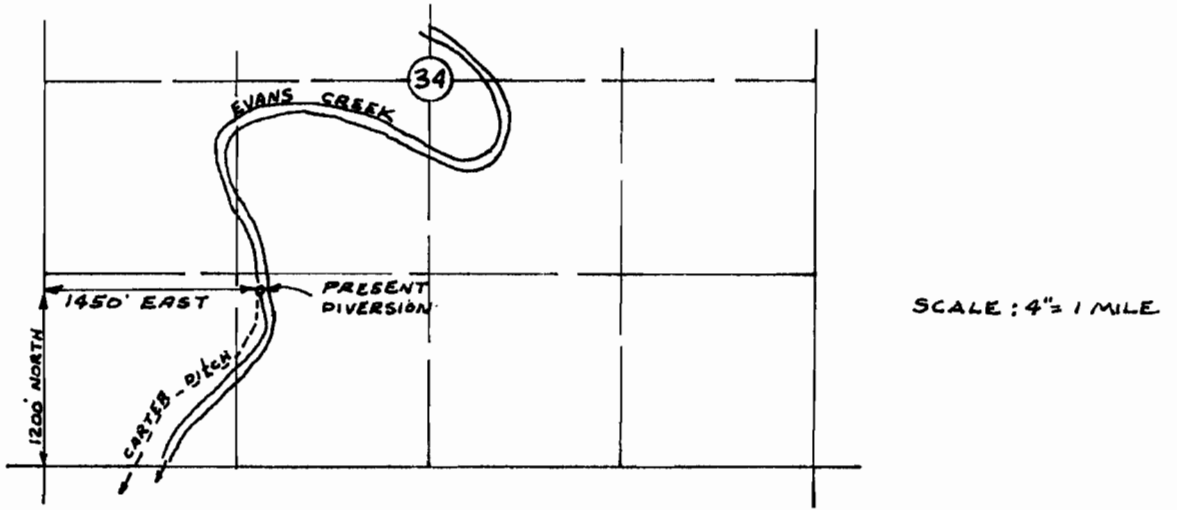

MAP TO ACCOMPANY APPLICATION OF PAUL B. DICKEY FOR A CHANGE IN POINT OF DIVERSION.

APRIL 28, 1965

RECEIVED
MAY 19 1965
COUNTY ENGINEER