


T.6N. R.35E. W.M.

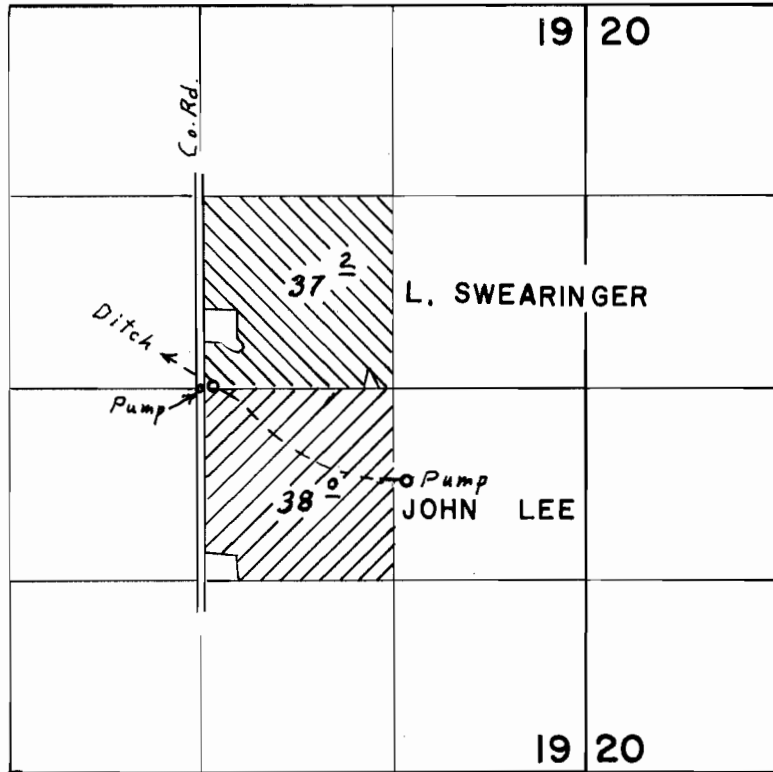


FINAL PROOF SURVEY UNDER

Application No. _____ Transfer D-115
Permit No. _____
IN NAME OF

.....
Surveyed May. 13. 19.71., by Greg. Bacon.....

T.6 N. R.34 E. W.M.

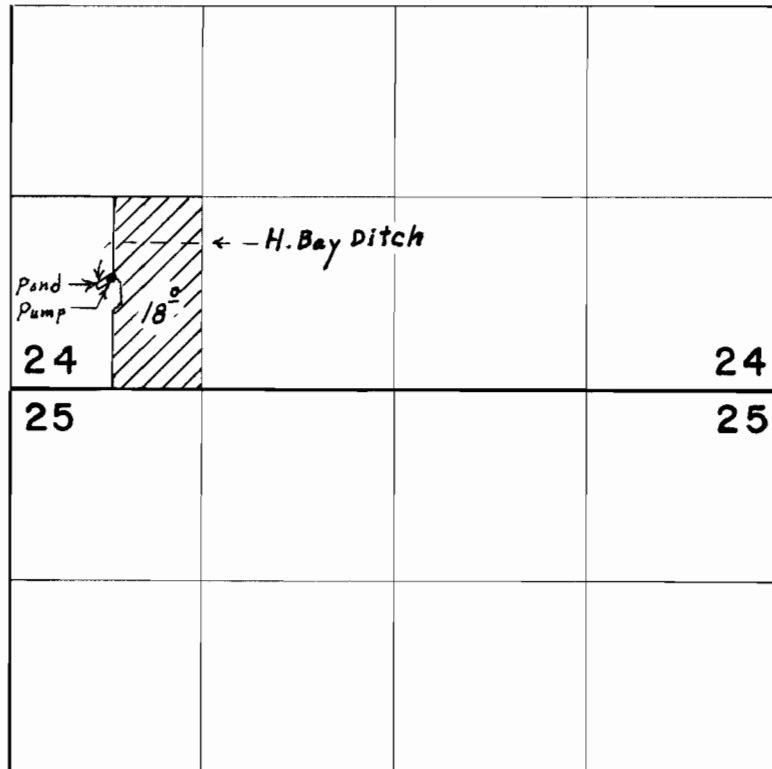


FINAL PROOF SURVEY
UNDER

Application No. _____ Transfer D-115
Permit No. _____
IN NAME OF

..... Lenard L. and Merna Lee Key

Surveyed May 11, 1971, by Greg Baca.....

T.6 N. R.34&35 E. W.M.

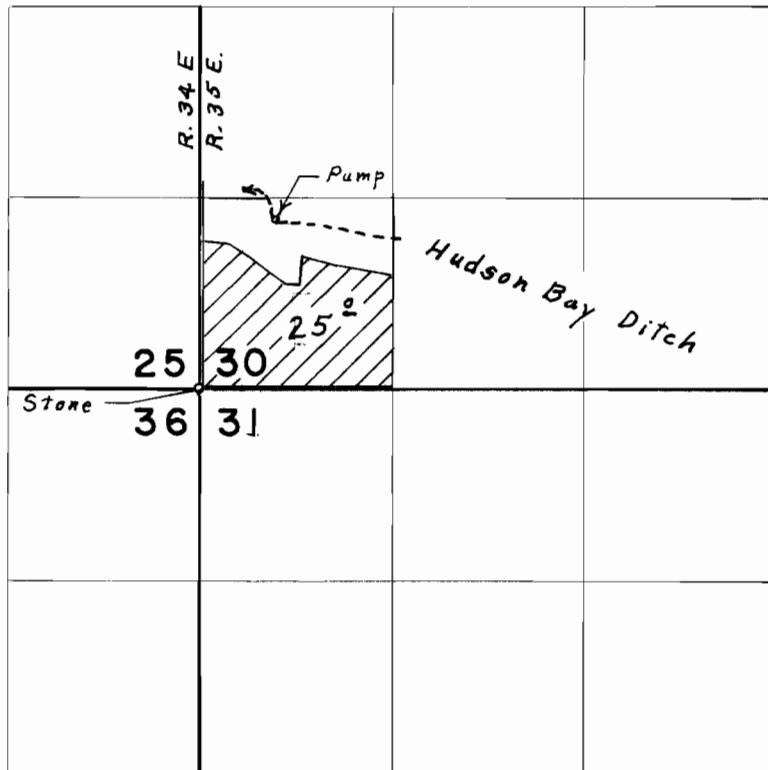

FINAL PROOF SURVEY
UNDER


Application No. Transfer D-115
Permit No.

IN NAME OF

.....
CECIL HANKLA
.....

Surveyed May 11, 1971, by Greg Baca.....

T. 6 N. R. 34 & 35 E. W.M.

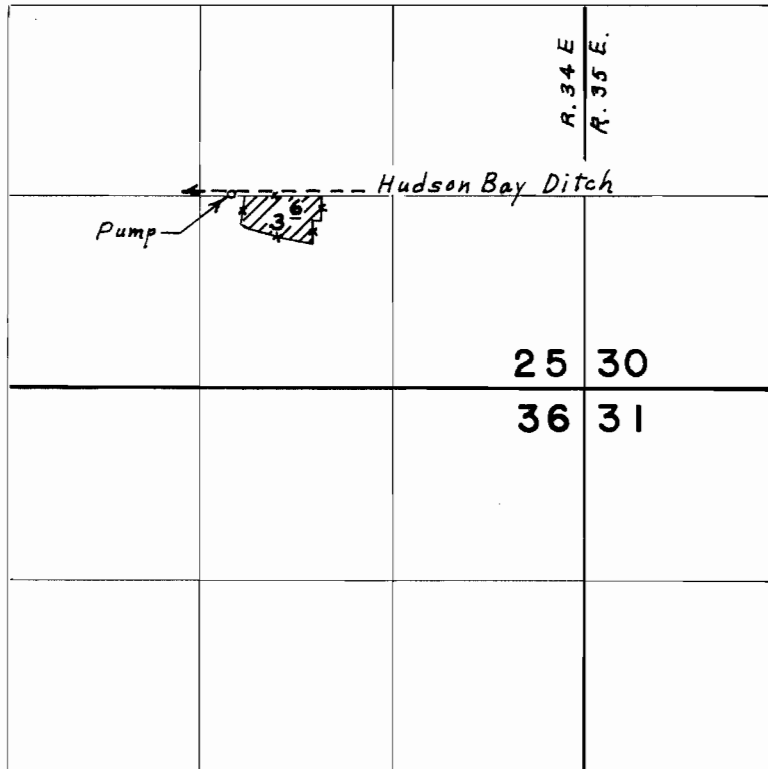

FINAL PROOF SURVEY UNDER


Application No. Transfer D-115
 Permit No.

IN NAME OF

D. R. ELLENBERGER

Surveyed May 11, 1971, by Greg Baca

T.5 & 6 N. R.35 E. W.M.

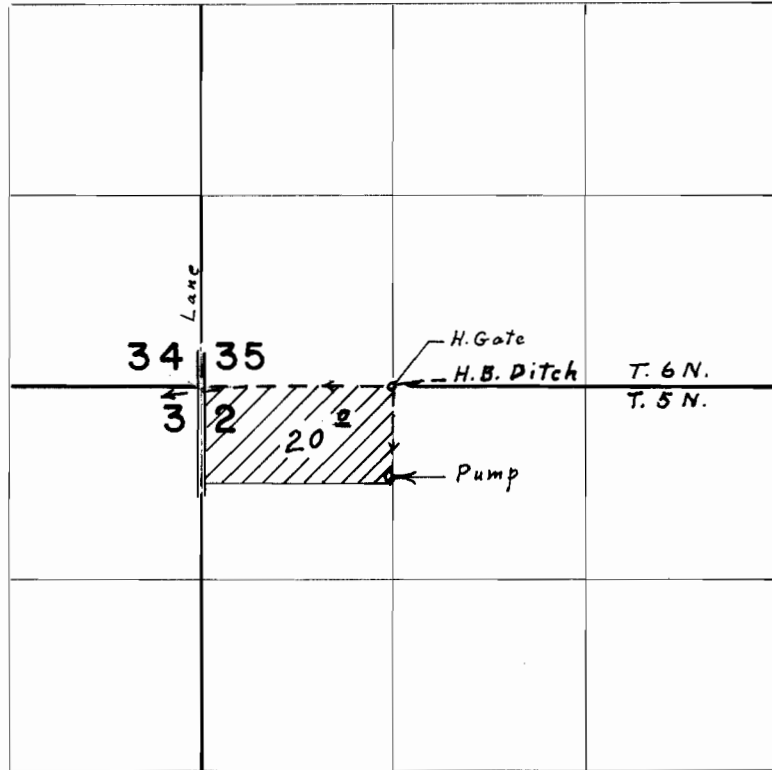

FINAL PROOF SURVEY
UNDER

Application No. _____ Transfer D-115
Permit No. _____

IN NAME OF

L. R. EDWARDS

Surveyed May 12, 1971., by Greg. Baca.