


T. 36 S., R. 1 W., W. M.

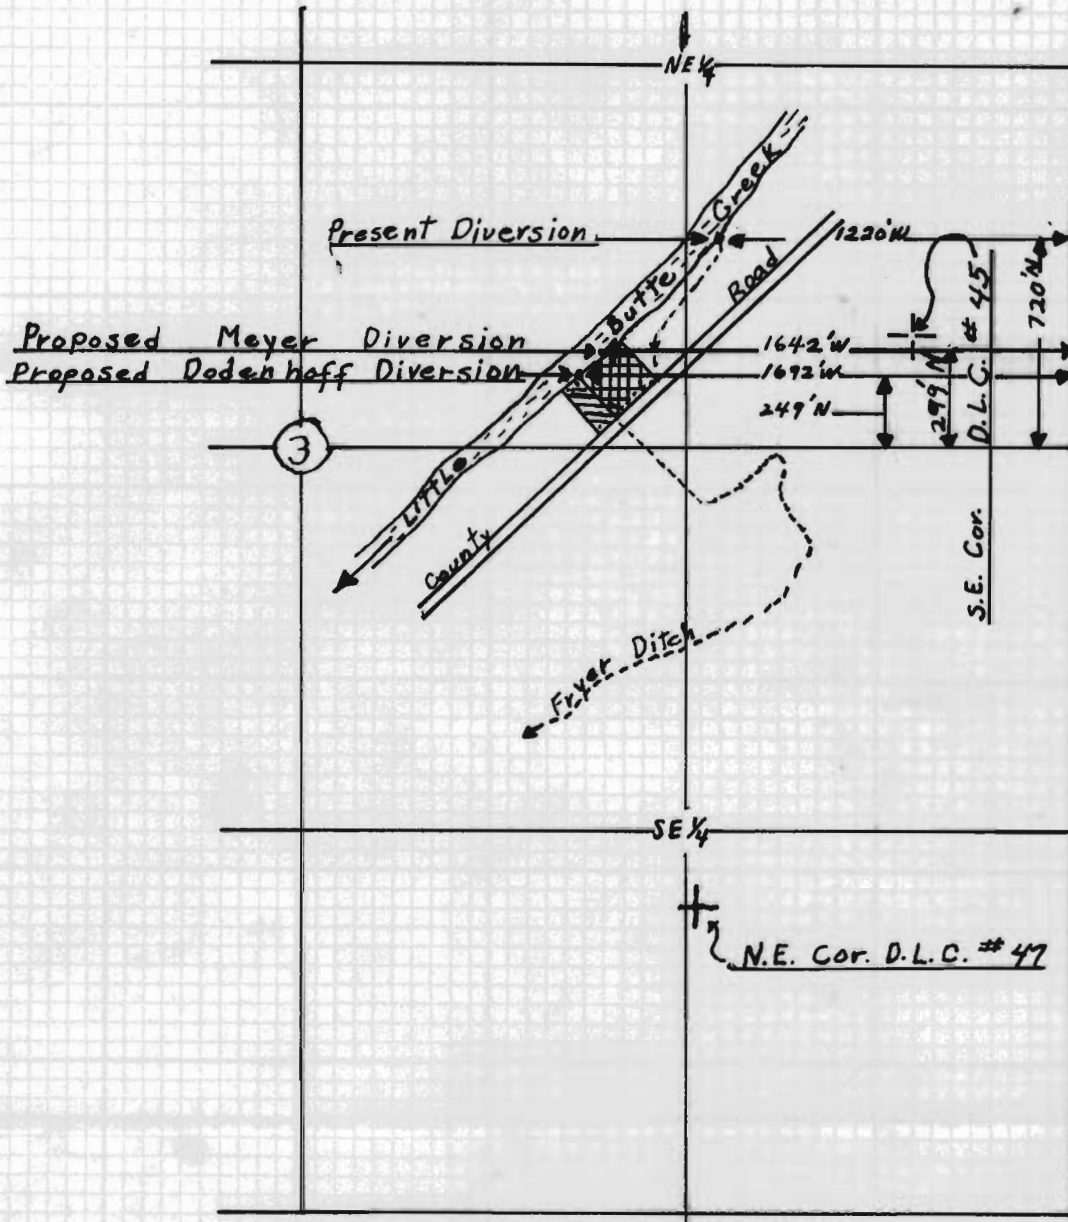

✓ see Vol. 9, P. 414
confirms this div. pt.

Larry A. Dodenhoff .2 acre represented by



Leland G. Meyer .6 acre represented by



Nov. 22, 1965

Scale: 8 inches = 1 mile

Map prepared by Leland G. Meyer

RECEIVED
NOV 26 1965
STATE ENGINEER
SALEM OREGON