


T.13 S., R.33 E., W.M.

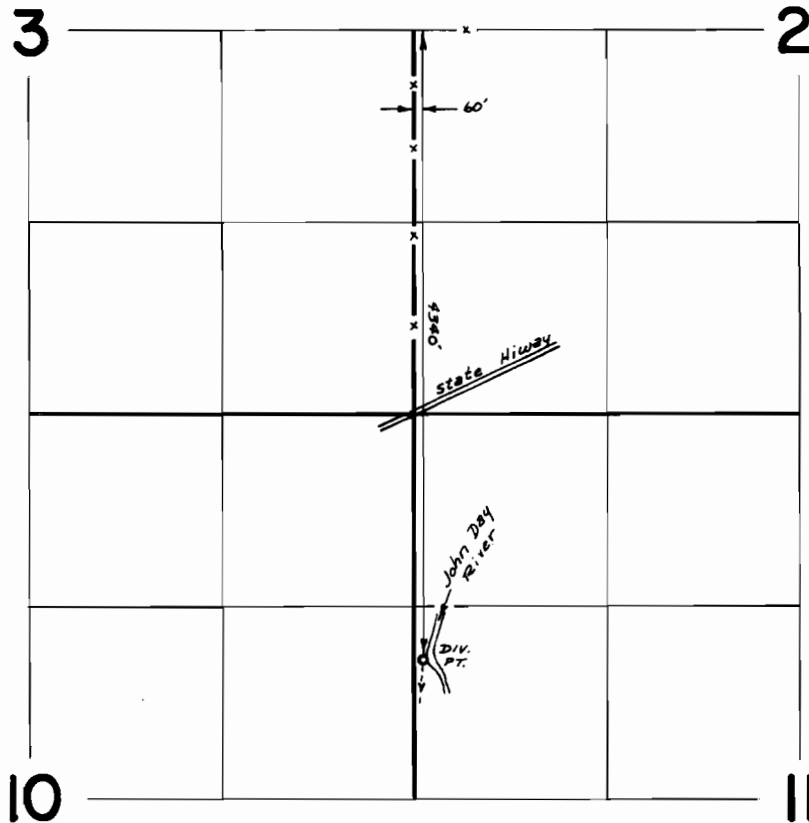

**FINAL PROOF SURVEY**  
UNDER

Transfer No. *D-117*  
Application No. .... Permit No. ....

IN NAME OF

*PAUL D DEXTER*

Surveyed *Aug 2* 19 *72*, by *D. Norby*