


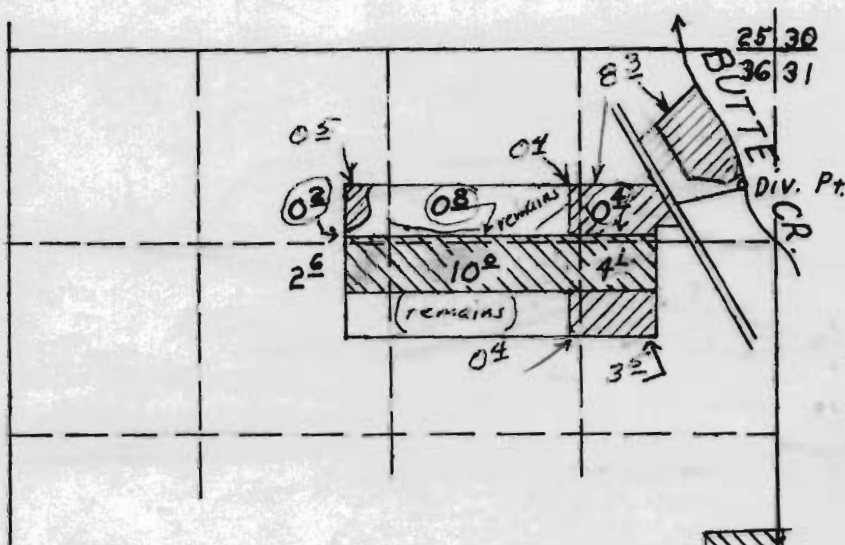

WALTER DUDA
T.5S.R.1W.W.M.

4" = 1 mile



Right under cert 16712 Transfd to 
 *right under cert 33193 transfer from lands land second map
 Right under cer 33193 transfer to 

RECEIVED
AUG 15 1968

STATE ENGINEER
SALEM OREGON