

185 11E

14





13

RIVER



DESCHUTES

23

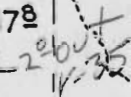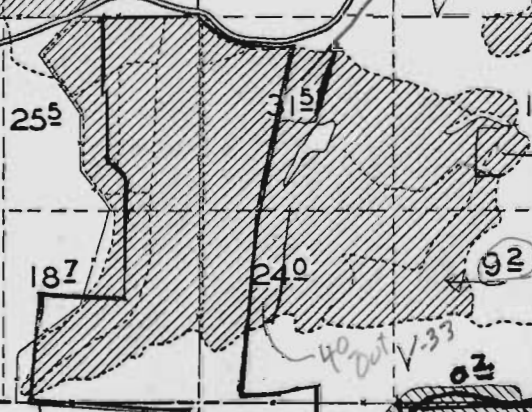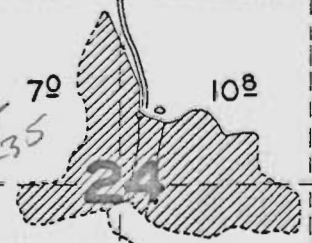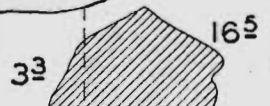

ARNOLD

CANAL

105

72

22

26

25

FLOW

7/A

