FINAL PROOF SURVEY

UNDER

TRANSFER NO. D-135
D-136
D-137

IN NAME OF

IRL DAVIS
H.A. FARGHER
FAWZY MALOUF

Surveyed July 16, 1975 by, T. PAUL

T.3S. R.10E. W.M.

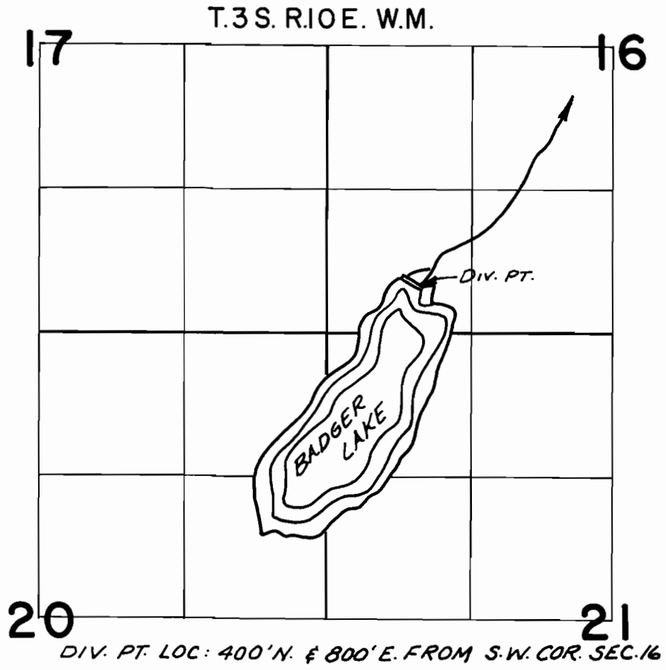

DIV. PT. LOC: 400'N. & 800'E. FROM S.W. COR. SEC. 16

T.3S. R.11E. W.M.

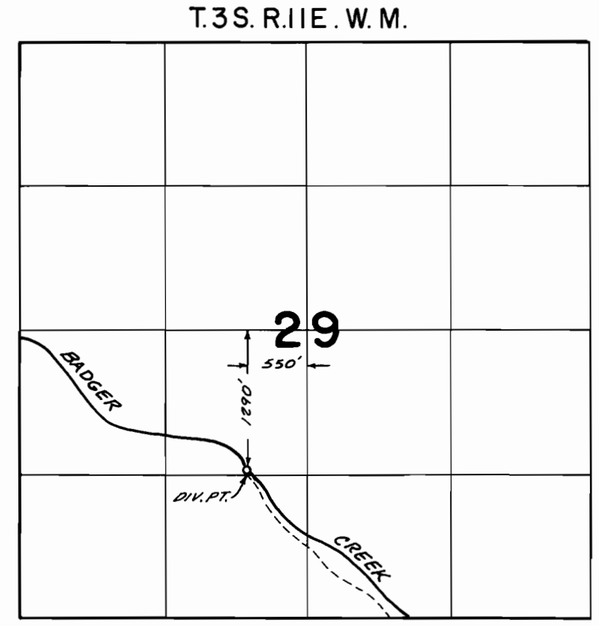

T.4S. R.12E. W.M.

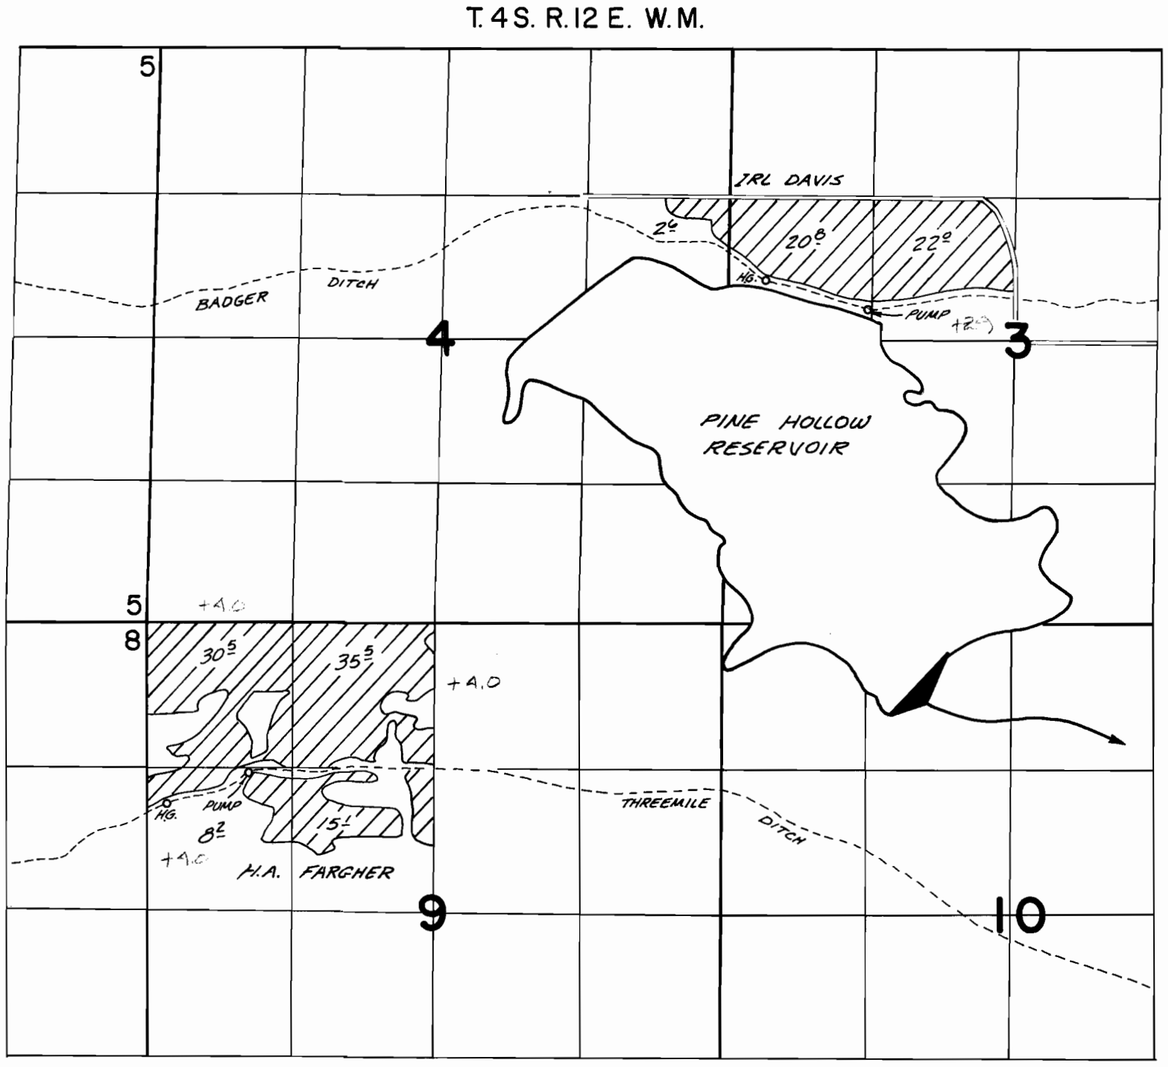

T.4S. R.13E. W.M.

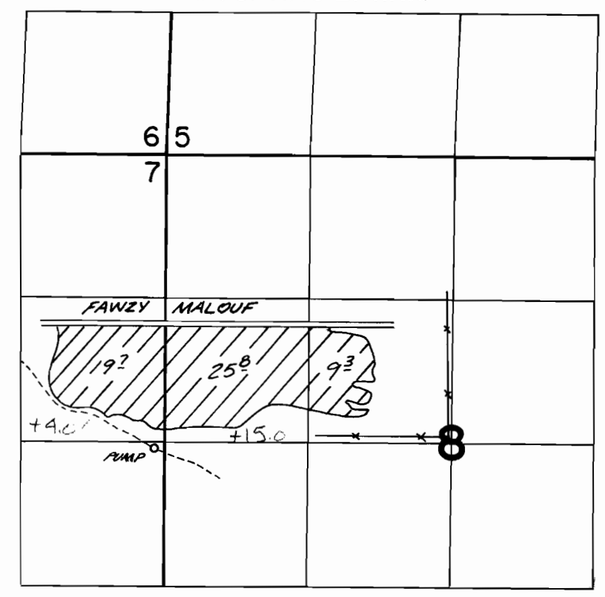

472-81 & 83, PTS 1975 H CRK