


T.8S.R. 38&39E.W.M.

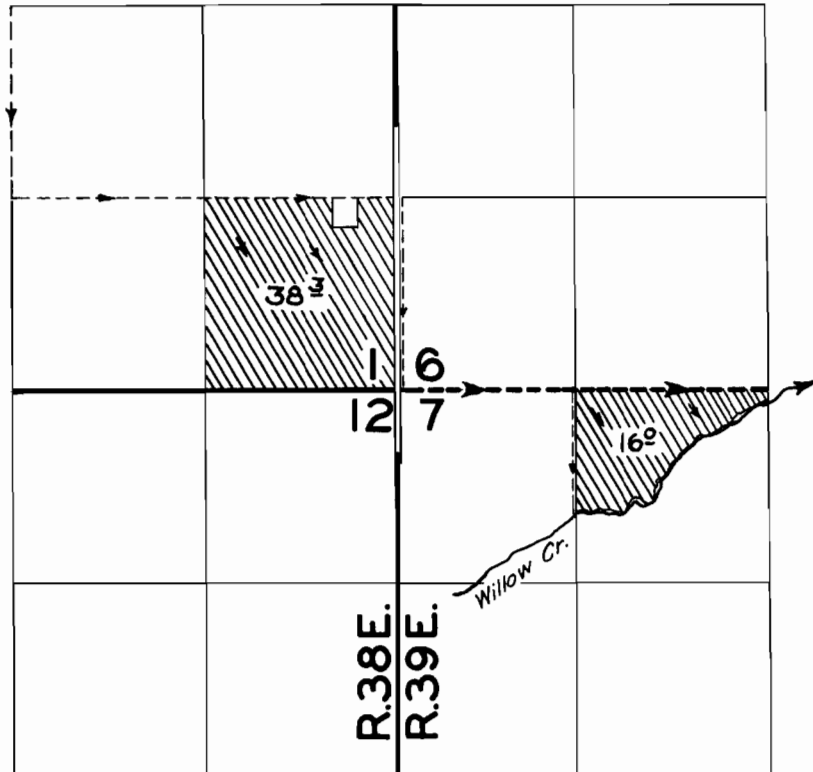

**FINAL PROOF SURVEY**  
UNDER

TRANSFER No. E-31

Application No. \_\_\_\_\_ Permit No. \_\_\_\_\_  
IN NAME OF

..... H.F. & MADGE EVANS .....

Surveyed SEPT. 15 1960, by [Signature]