


T.27S. R.15E.W.M.

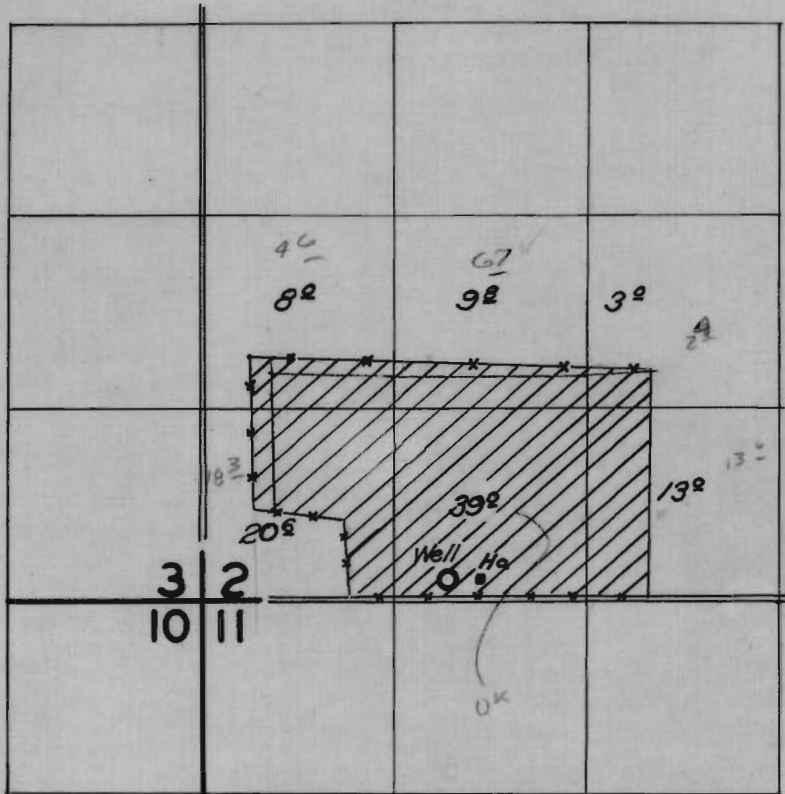

FINAL PROOF SURVEY
UNDER

Transfer E-33
Application No. Permit No.
IN NAME OF

Edwin A. Eskelin

Surveyed *Sept. 13, 1962*, by *Carl R. Baker*...