


T.13S.R.29E.W.M.

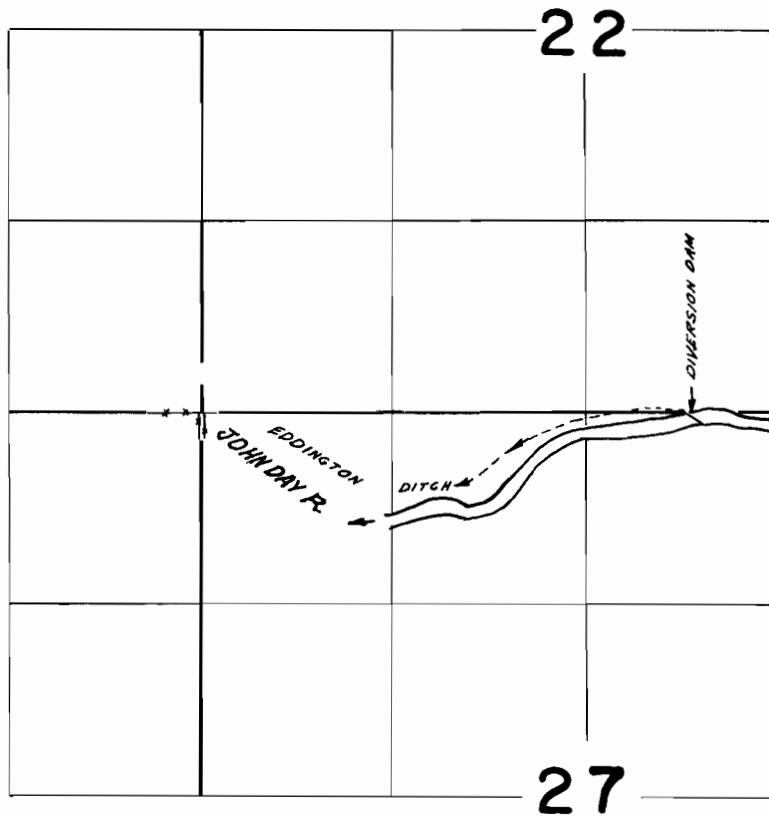

DIVERSION POINT LOCATED 50 FT. S. & 3380 FT. E. FROM
N.W. CORNER SECTION 27

FINAL PROOF SURVEY
UNDER

TRANSFER E-45

Application No. _____ Permit No. _____
IN NAME OF

EDDINGTON DITCH CO.

Surveyed *July 15, 1968*, by *Wd. Ruppert*