


T.9S.R.6W.W.M.

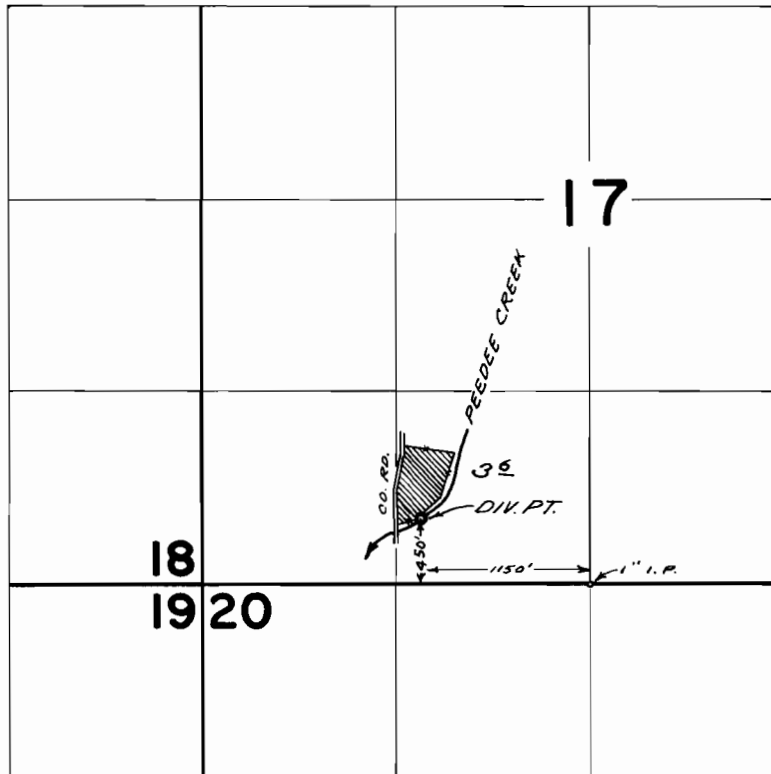

FINAL PROOF SURVEY
UNDER

TRANSFER NO. E-46

Application No. _____ Permit No. _____

IN NAME OF

M. S. EAKIN

Surveyed *MAR 25 1969*, by *D. BUELL*