


T.36S.,R.1W.,W.M.

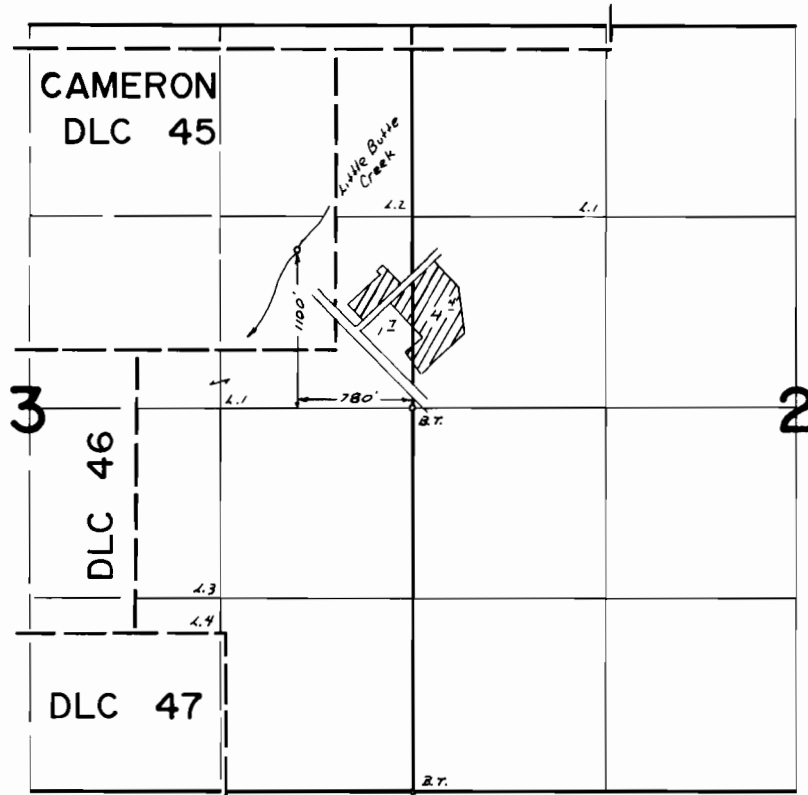

FINAL PROOF SURVEY UNDER

Transfer No. E-51
Application No. Permit No.
IN NAME OF

EAGLE POINT SCHOOL DISTRICT NO. 9

Surveyed Aug. 19. 19.75, by L. E. Gould