


T.5S.R.7 W.W.M.

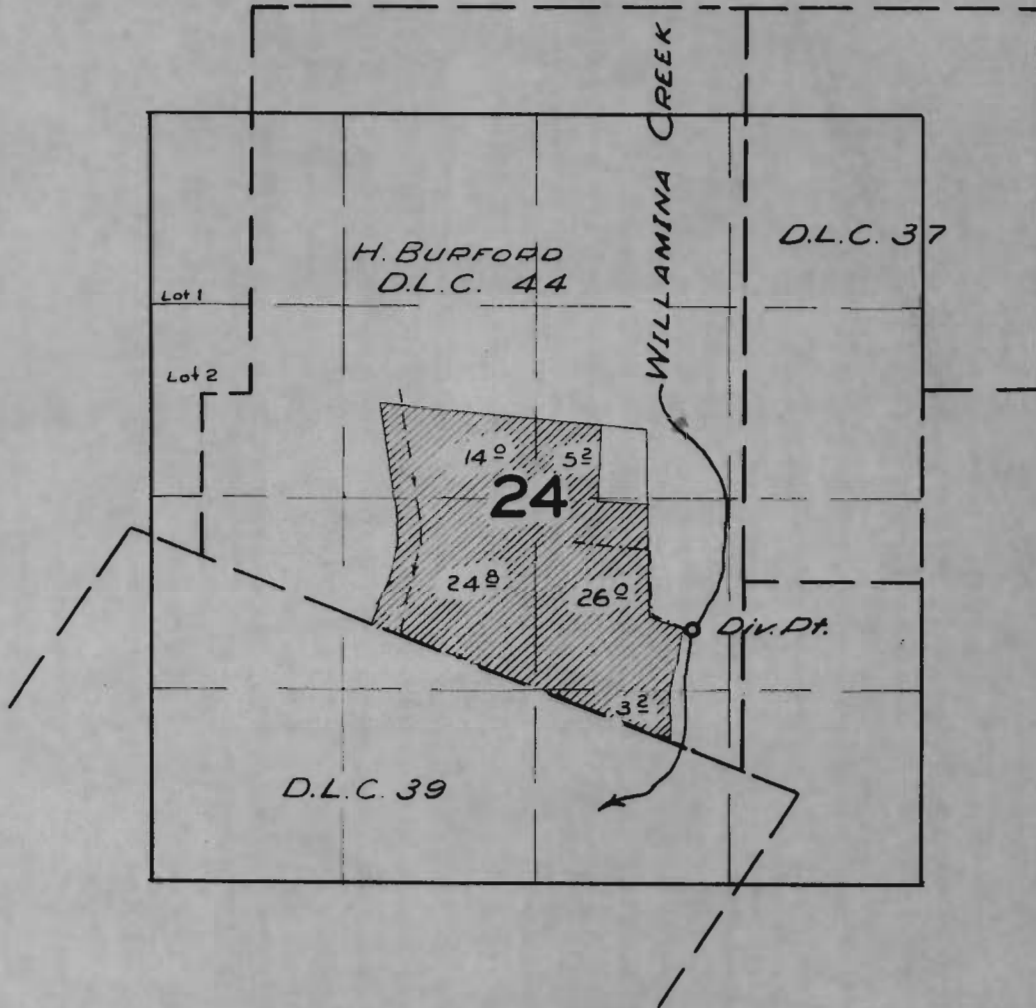

FINAL PROOF SURVEY
UNDER

Transfer No. F-41
Application No. 32935 Permit No. 26028
IN NAME OF

ELDON FENDALL

Surveyed 19 MAY 1960, by M. B. B.