

F-48


PLAT SHOWING LAND IRRIGATED
WEST HALF SE 1/4 SECTION 32-TP. 16S. R. 12E. W.M.
SCALE 1" = 100' - SEPT. 20 - 1964
TORNBOM + WARNER.

PORTION NW 1/4 SE 1/4 Sec. 32-16-12
2 Acres Irrigated

2.0 Acres

3.0 ACRES

PORTION SW 1/4 SE 1/4 Sec. 32-16-12
3 Acres Irrigated.

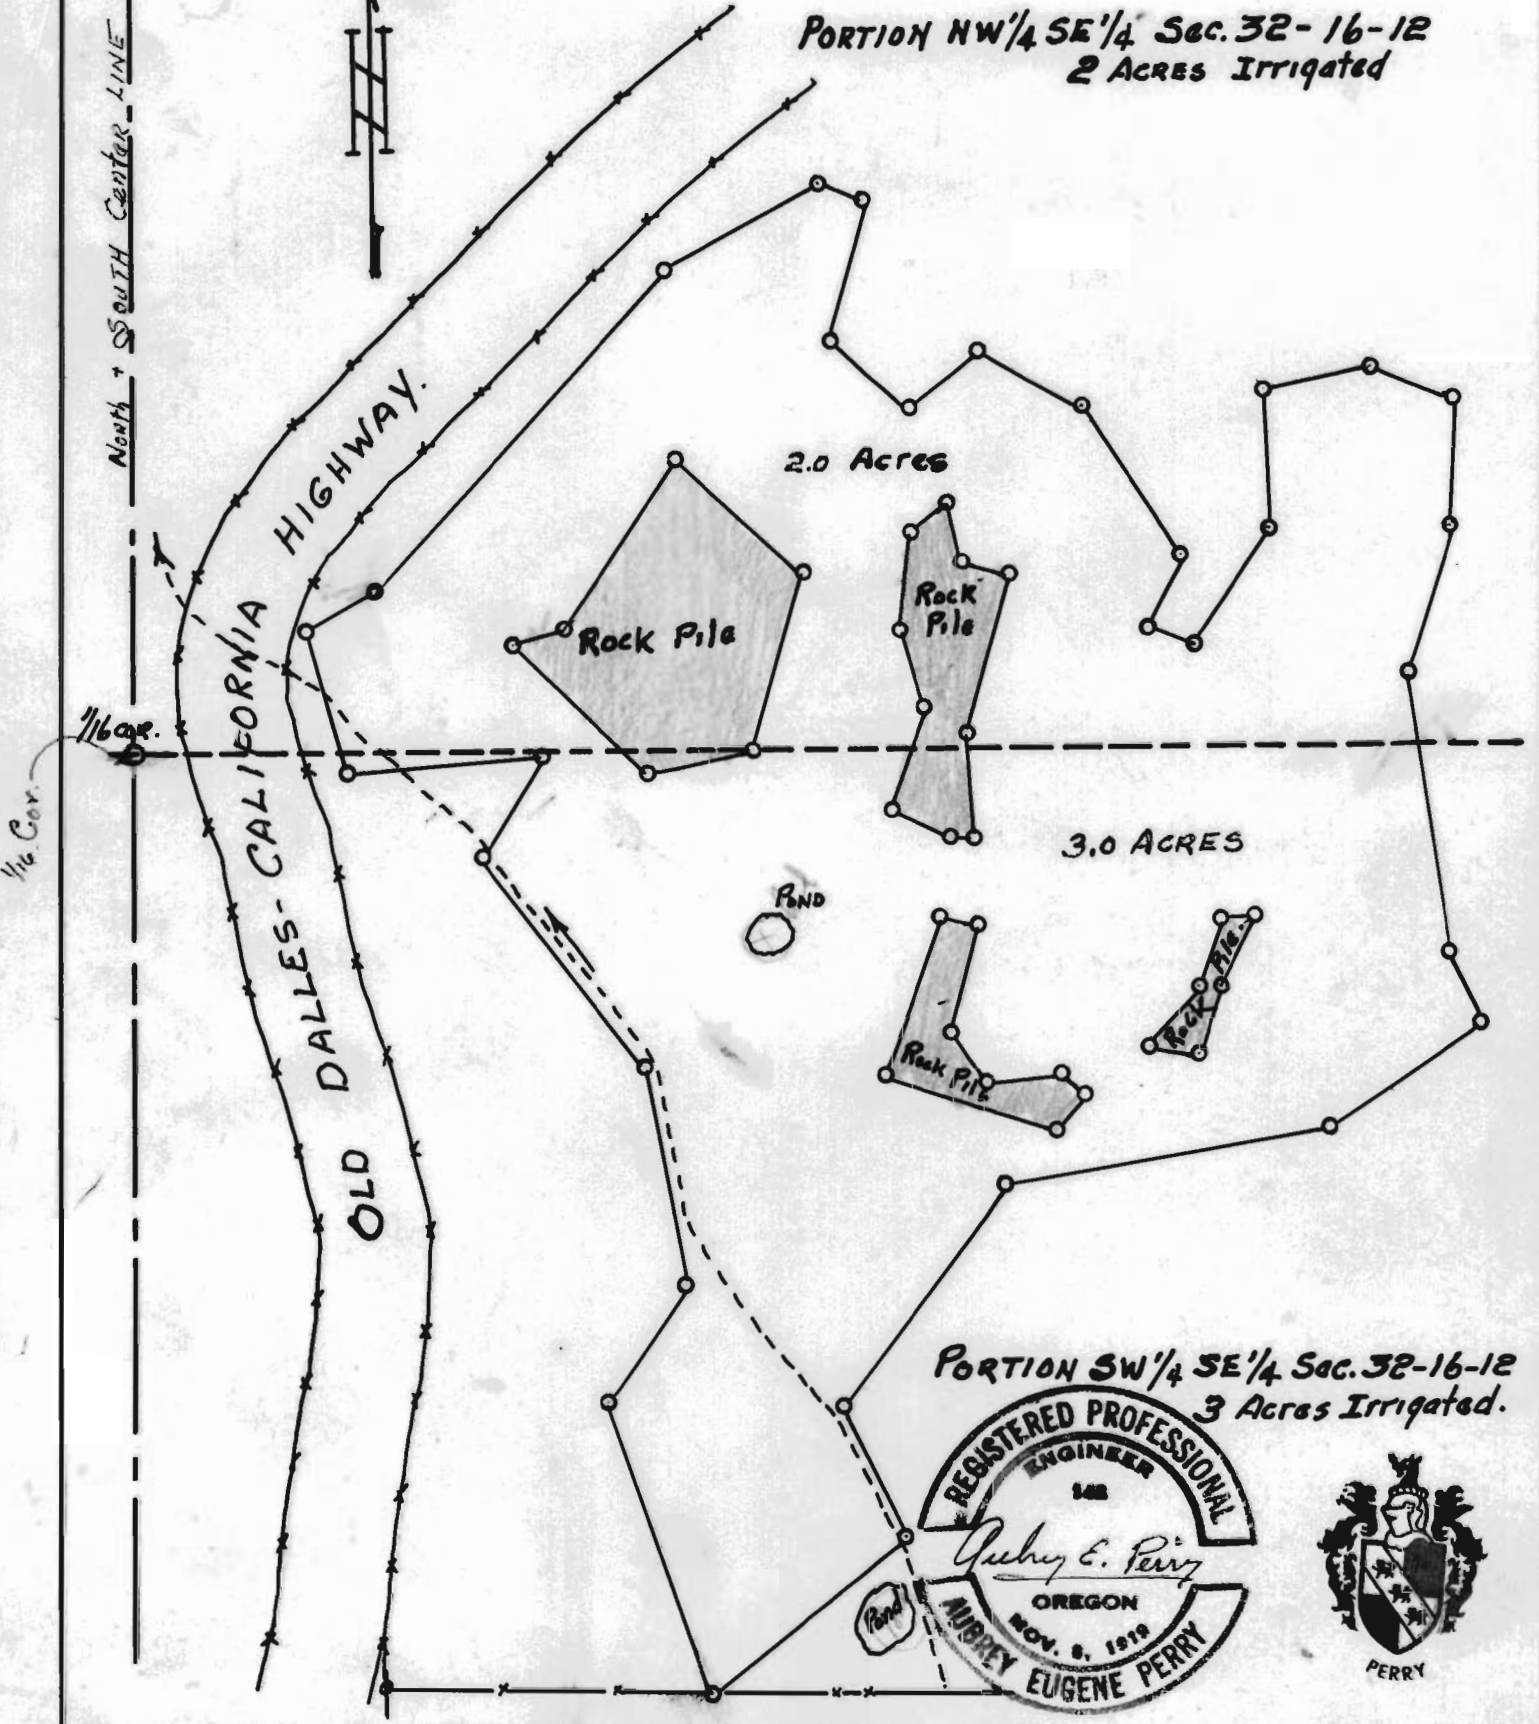

At time Perry surveyed it he said it was irrigated and sowed to rice. gcf