


# T. I. S. R. 14 E. W. M.

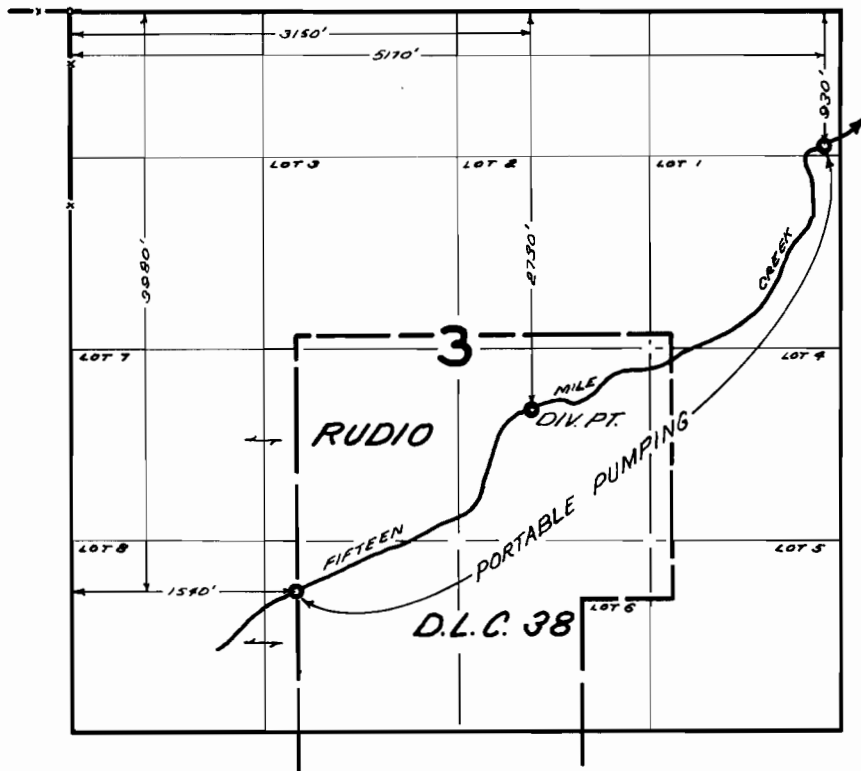

## FINAL PROOF SURVEY UNDER

TRANSFER No. F-50

Application No. .... Permit No. ....  
IN NAME OF

**GEORGE G. FAX**

Surveyed Nov. 16, 1967, by W. J. RUPPERT