


# T.13&14S., R.5W., W.M.

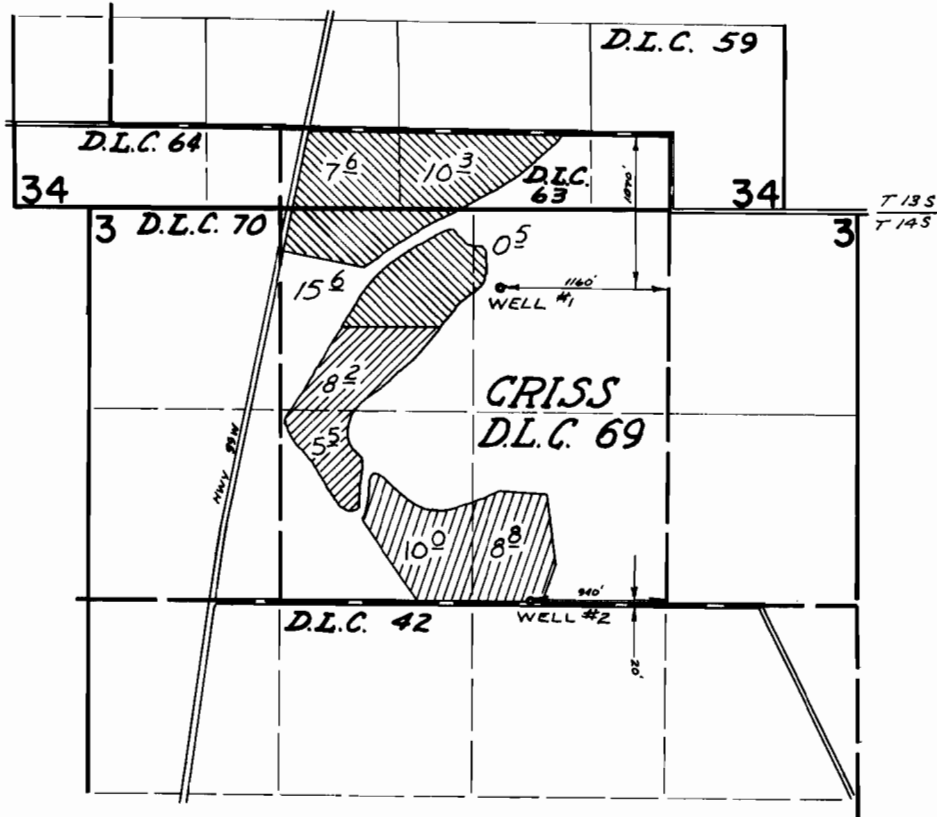

## FINAL PROOF SURVEY UNDER

Transfer No. F-75  
 Application No. G-5056 Permit No. G-4766  
 IN NAME OF

WILLIAM L. FRANKLIN

Surveyed JUNE 8, 1973, by D. NORBY

WELL #1      WELL #2  
