


T.2S.R.45E.W.M.

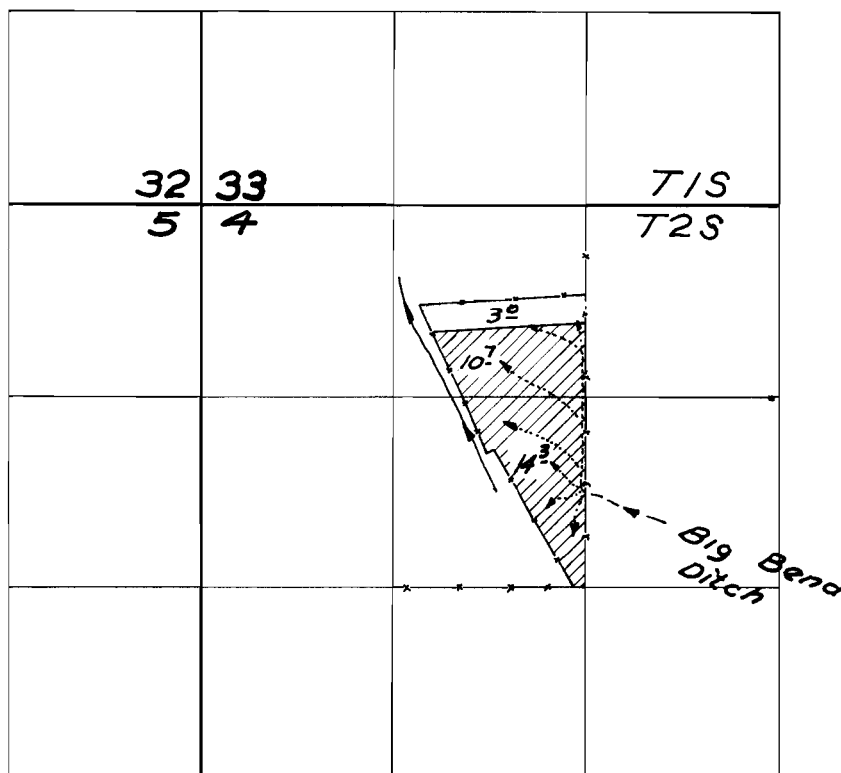

FINAL PROOF SURVEY UNDER

Transfer F 7
Application No. Permit No.
IN NAME OF

..... *PAUL J. YOST*

Surveyed *June 22 1966*, by *V. GARNER*.....