


SECTION

TOWNSHIP 40 S, RANGE 7 W., W. M.

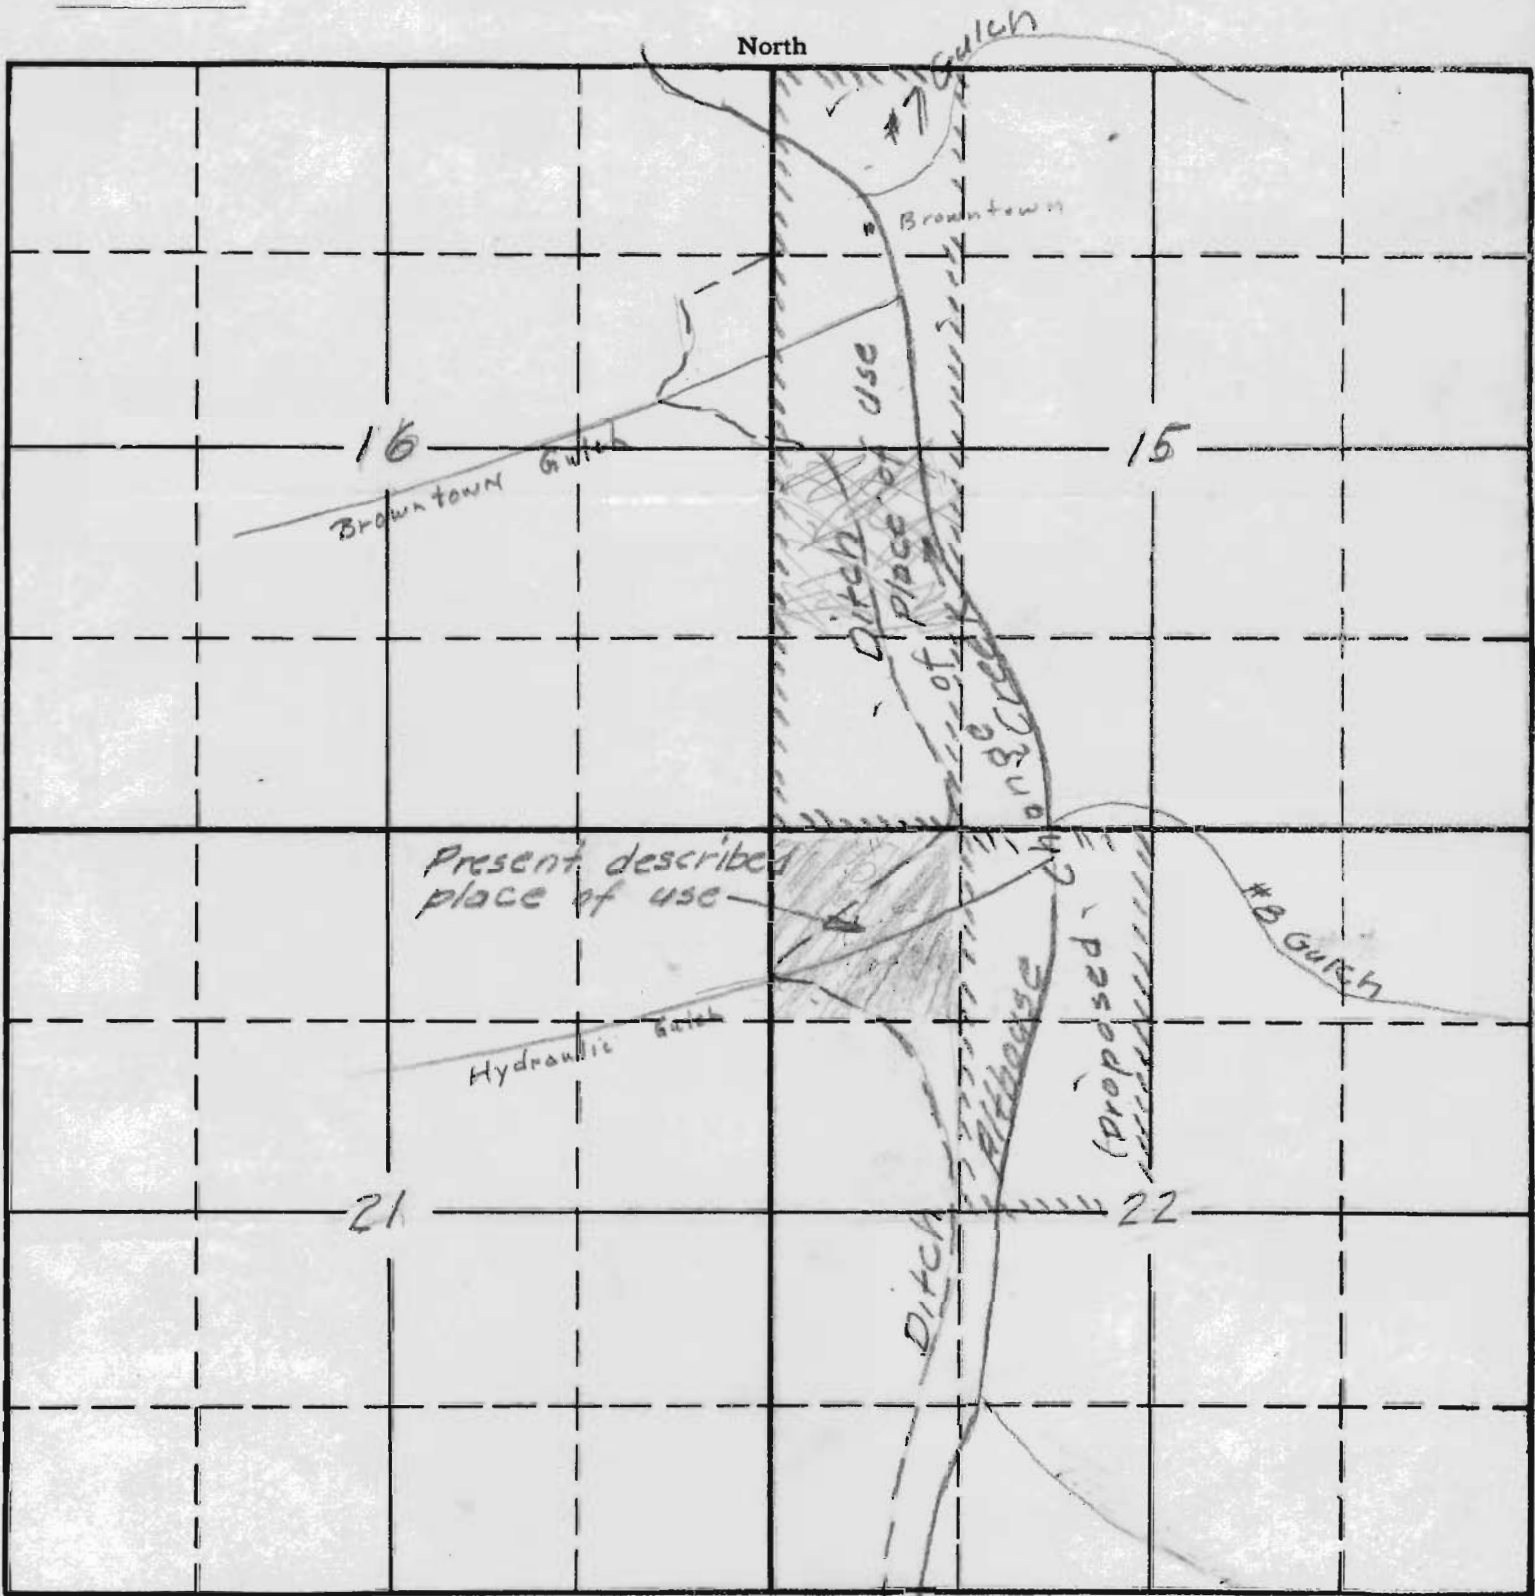

APPLICATION No.

PERMIT No.

SW 1/4
NW 1/4
sec 27

Diversion

2.7