


T. 39 S. R. 8 W. W. M.

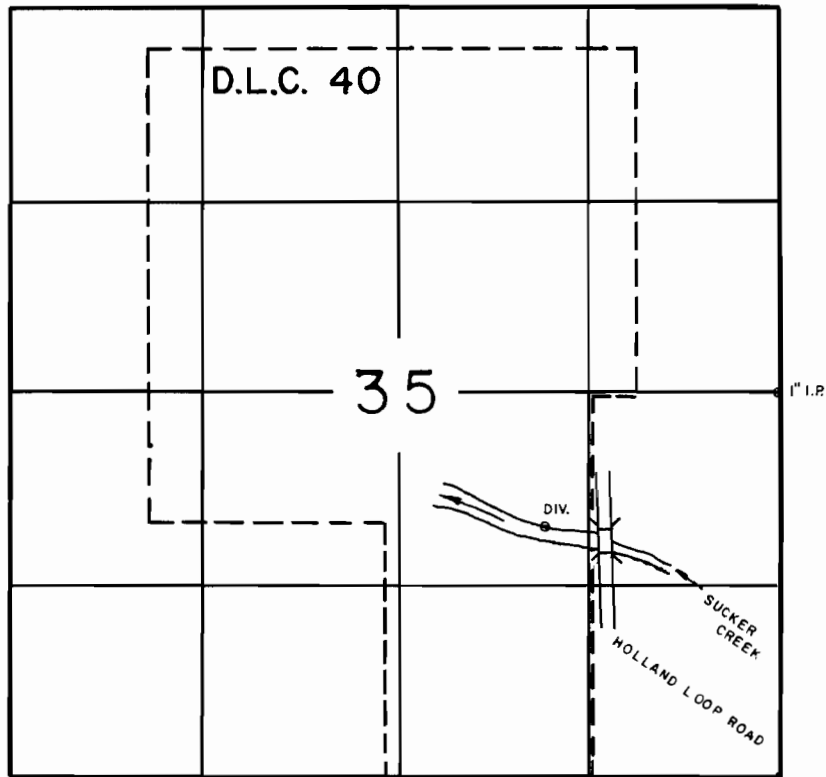

**FINAL PROOF SURVEY**  
UNDER

TRANSFER

Application No. F-38 Permit No. ....  
IN NAME OF

**ASHBY FULK**

Surveyed DECEMBER 21 1965, by R. B. STEIMER.