


T. 32S. R. 6W. W.M.

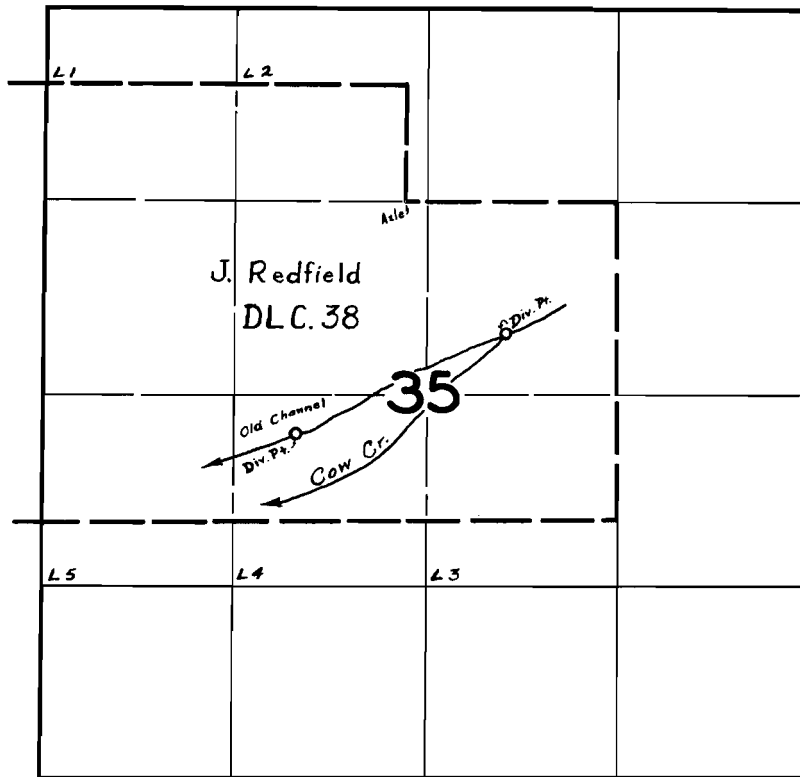

**FINAL PROOF SURVEY**  
UNDER

Application No. G-39 Permit No. ....  
IN NAME OF

**W. B. GARRETT, ET AL**

Surveyed JUN. 18 1959, by M. BISH