

T. 5 S., R. 3 E., W. M.

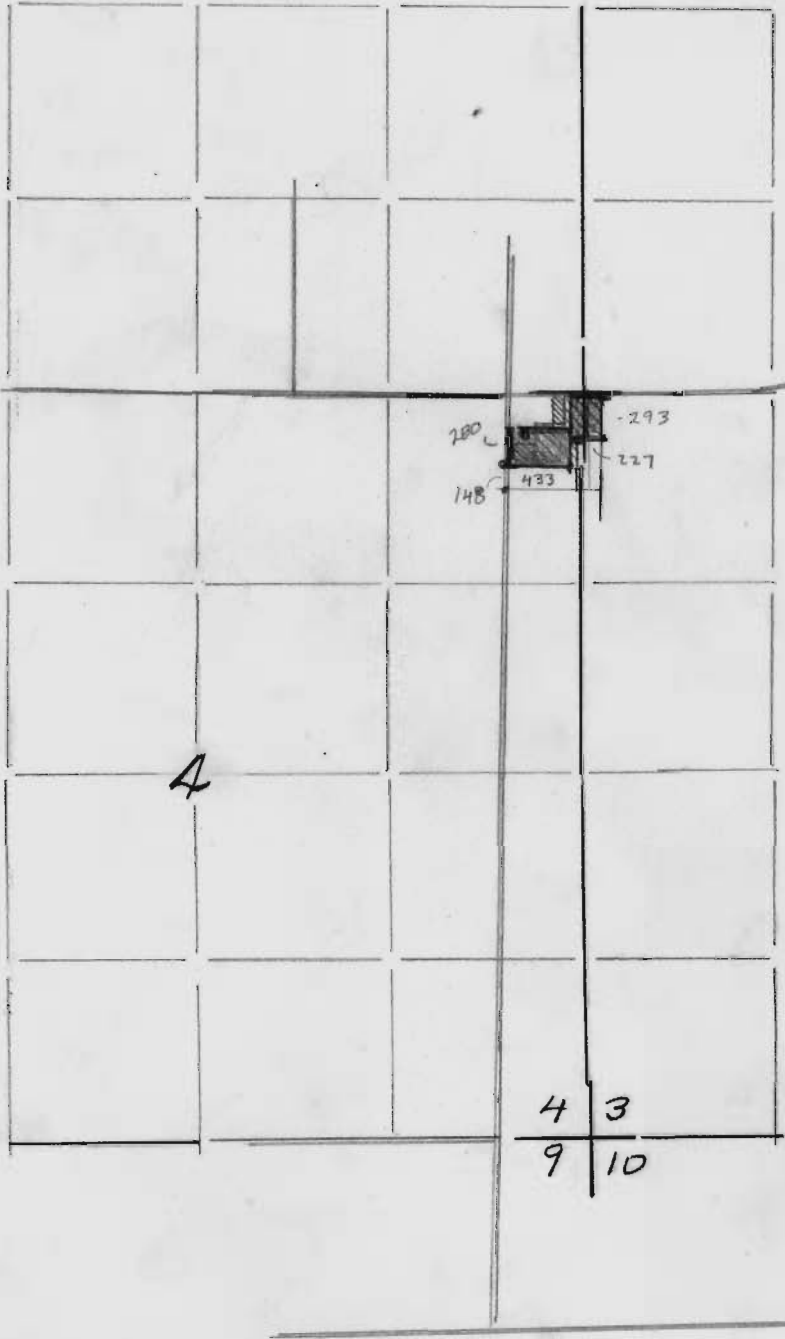


Photo: DFK-5P-19 flown - 7-15-56

Inspection: July 12, 1960 -

W.A. Carr