


T. 1 S. R. 13 E. W. M. W. M.

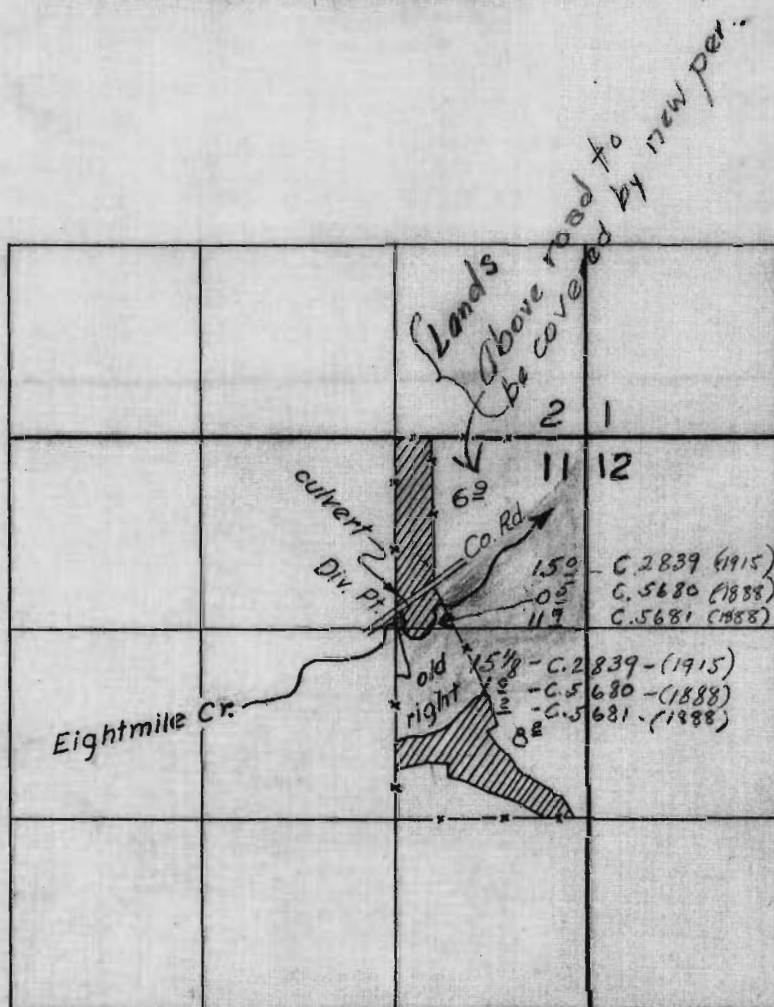

FINAL PROOF SURVEY
UNDER

Area shaded in red has vested water rights
L.W.U.

Application Transfer Nomit G-50
IN NAME OF

Halbert Gerking

Surveyed April 5 1962, by L. Whitehouse