


# T.5N.R.36 E.W.M.

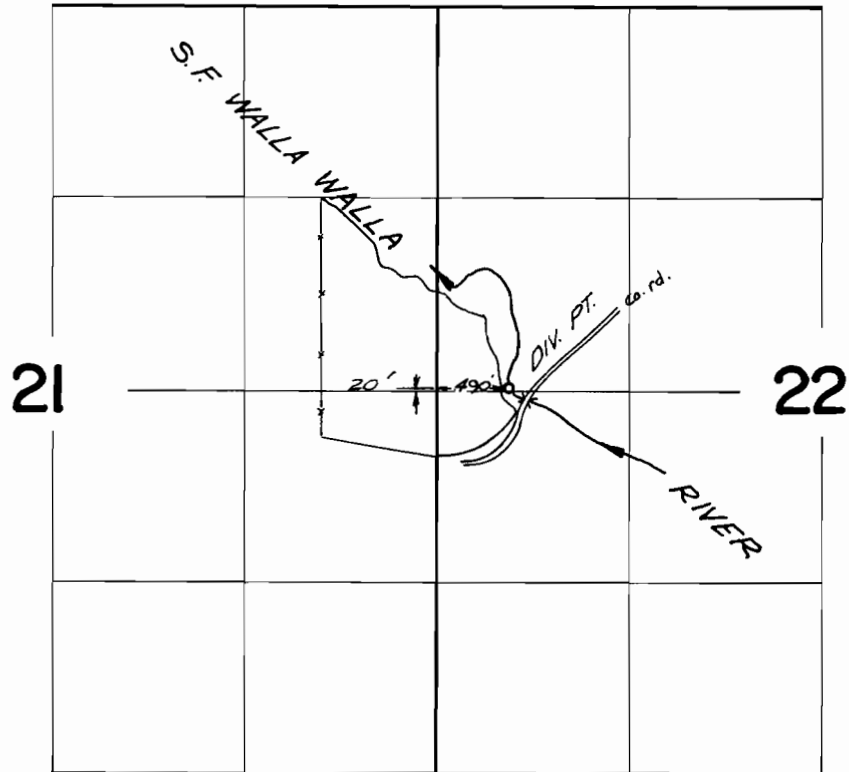

## FINAL PROOF SURVEY UNDER

Application No. \_\_\_\_\_ Permit No. \_\_\_\_\_  
IN NAME OF

*OZRO GRAHAM*

Surveyed *Nov. 3, 1966*, by *V. GARNER*