


T.29S.R.12 W. W.M.

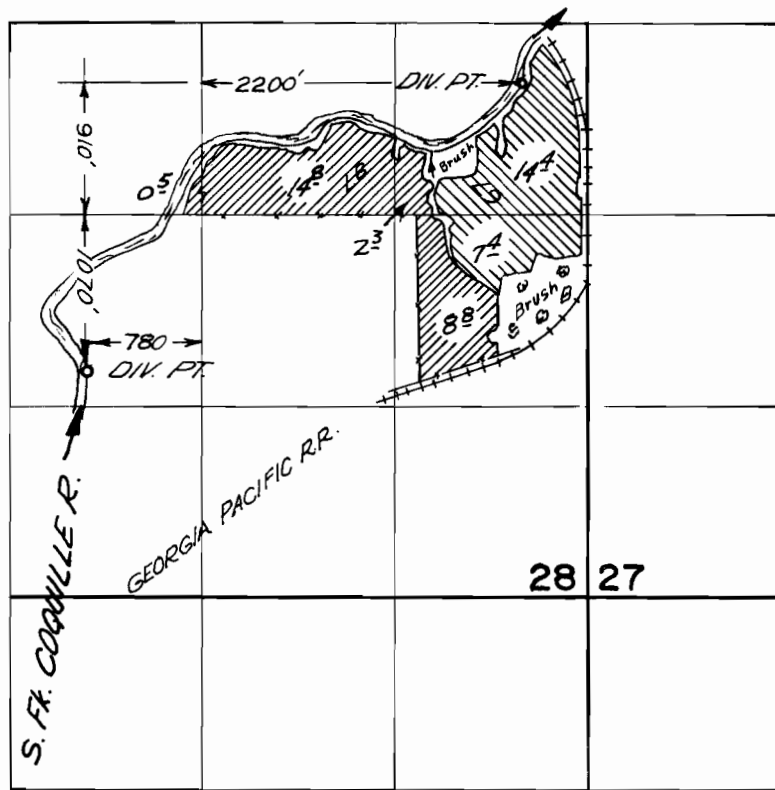

FINAL PROOF SURVEY
UNDER

Application No. _____ Permit No. _____
IN NAME OF

GEORGIA PACIFIC CORPORATION

Surveyed Oct. 6 1966, by V. GARNER