


T.18S. R.12E.W.M.

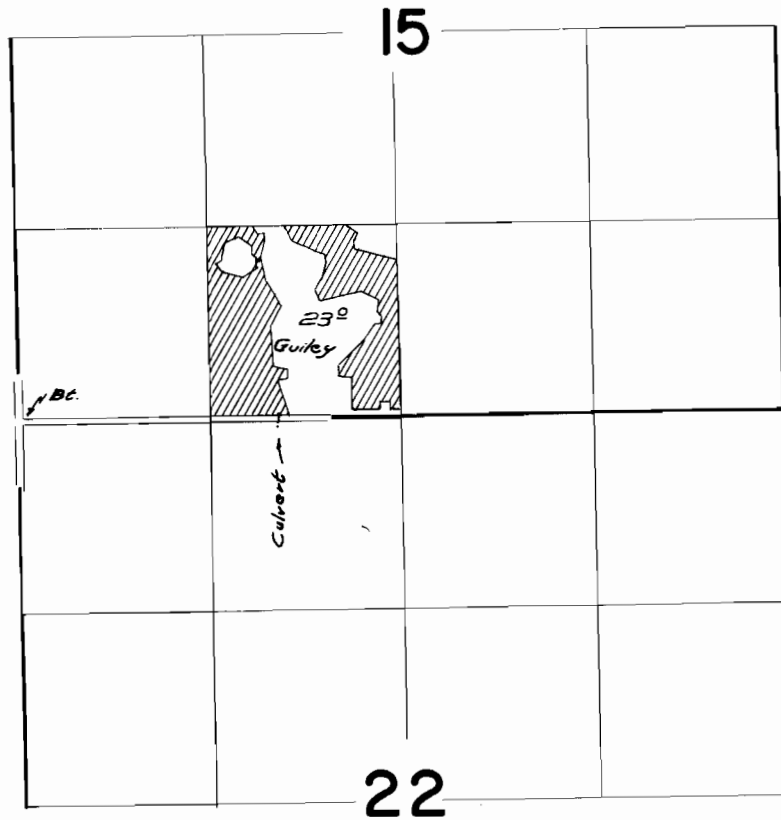

FINAL PROOF SURVEY
UNDER

Transfer G-60
Application No. Permit No.
IN NAME OF

.....
Surveyed *Sept 1 & 2 1966*, by *W.J. Ruppert*