


T.5&6S.,R.6W.,W.M.

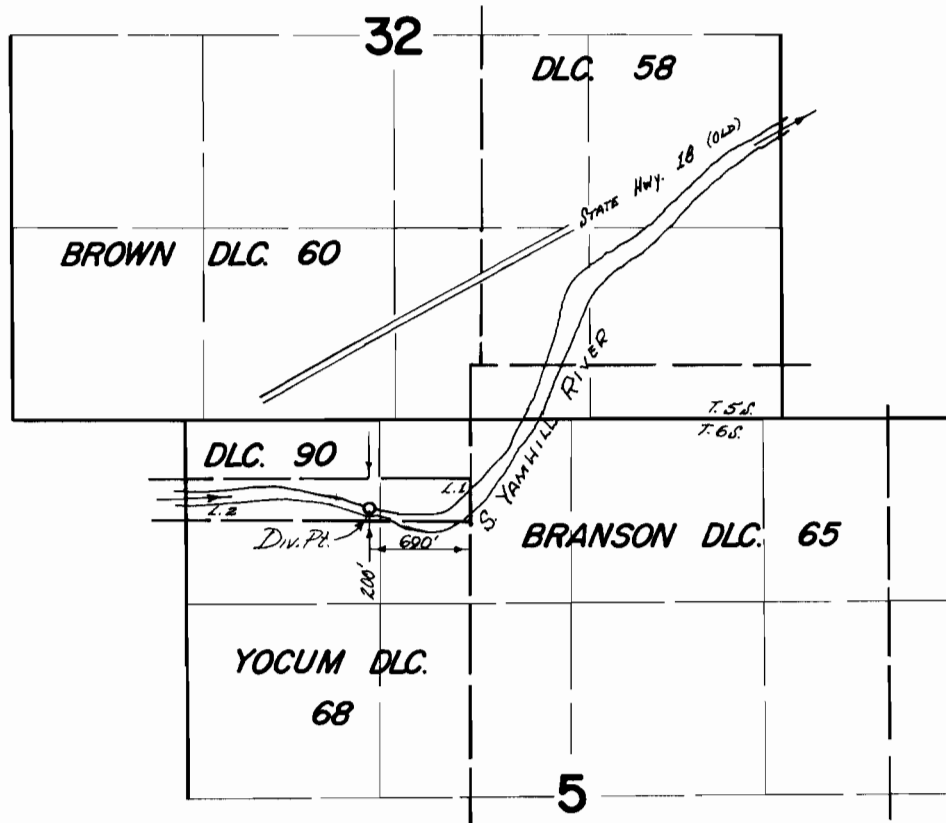

FINAL PROOF SURVEY
UNDER

Transfer No. G-70

Application No. _____ Permit No. _____
IN NAME OF

ROBERT GALINAT

Surveyed May 7 1973, by D. N. N. N.