


T. 37S. R. 3E. W.M.

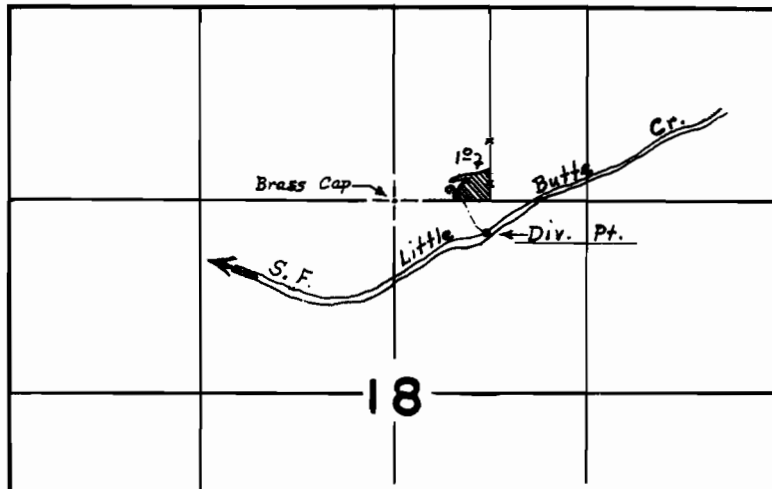

Div. Pt. is located 1535' S. & 625' E. from N<sup>1</sup>/<sub>4</sub> Corner Section 18.

**FINAL PROOF SURVEY**  
UNDER

Transfer No. G-73  
Application No. \_\_\_\_\_ Permit No. \_\_\_\_\_  
IN NAME OF

**LOYD GEORGE**

Surveyed **Jan. 28** 1971, by **D.C. Hendrix**