


T. 7 S. R. 1 W. W. M.

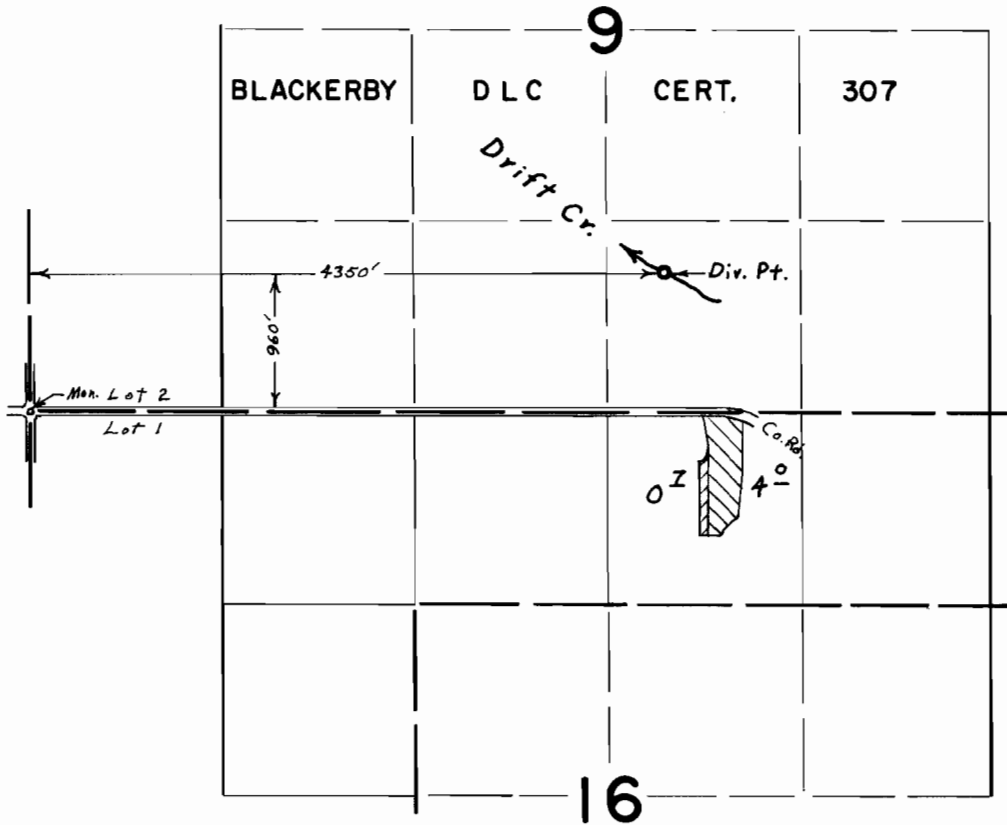

FINAL PROOF SURVEY UNDER

Application No. _____ Transfer Permit No. _____
G-76 
G-75 

IN NAME OF

J. L. GEHRING

Surveyed May 27, 1970, by L. E. Gould