


TOWNSHIP 6 S. RANGE 1 E.

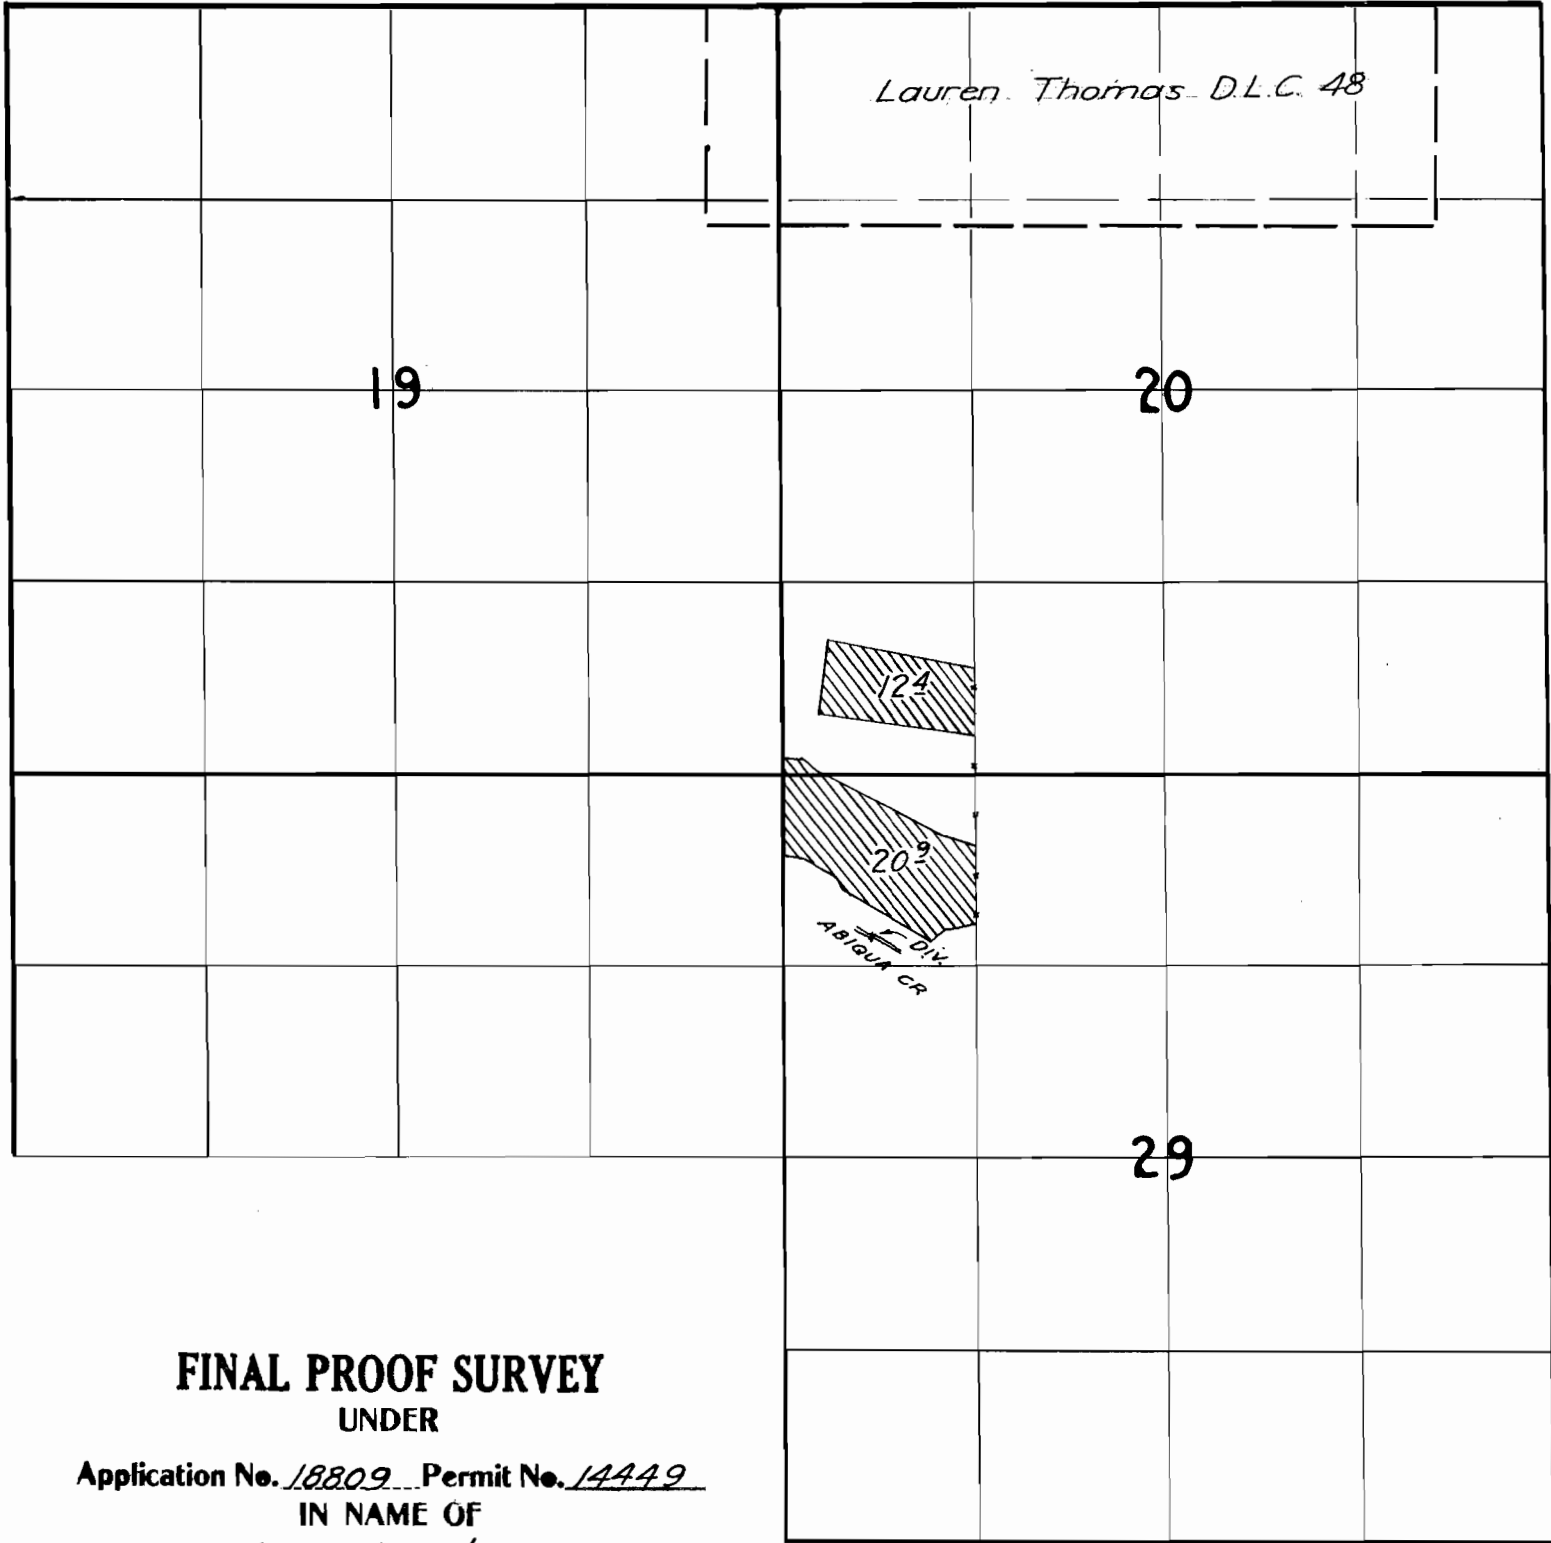

FINAL PROOF SURVEY
UNDER

Application No. 18809 Permit No. 14449

IN NAME OF

John Morley

Surveyed May 9 1941, by C. Humming