



NE NW Sec. 23, T16S, R12E W1/4
From which water is being transferred

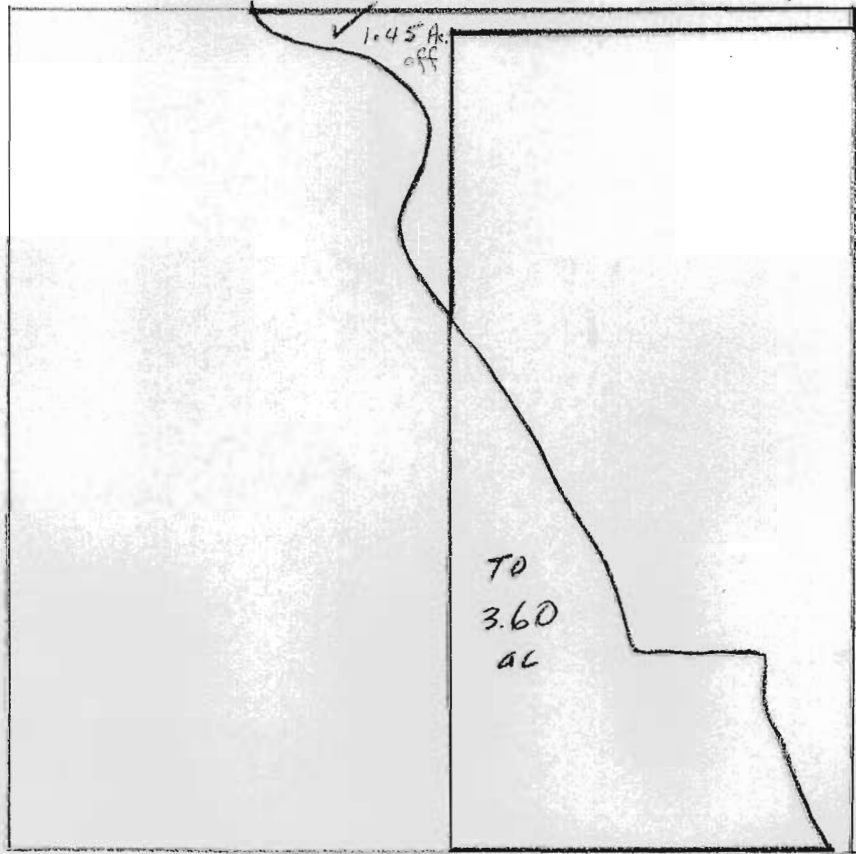

Scale
1" = 300'



SE SW Sec. 14, T16S, R12E W
From which water is being transferred

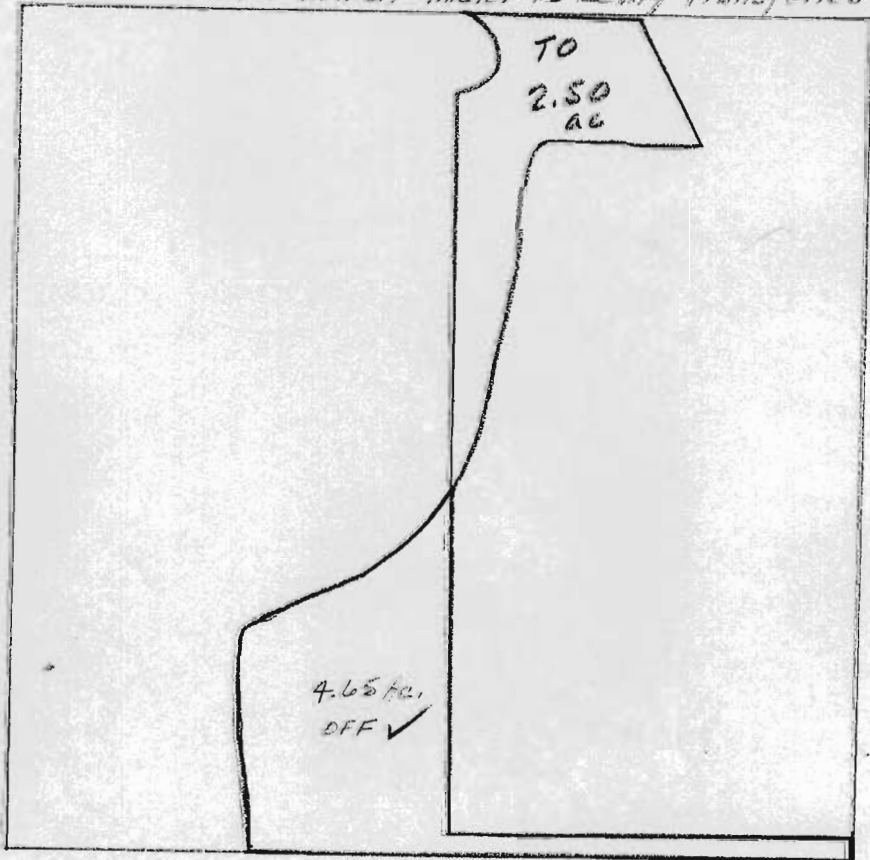

Scale
1" = 300'



RECEIVED
JUN 19 1968
STATE ENGINEER
SALEM OREGON