


# T. 7 S., R. 1 W., W.M.

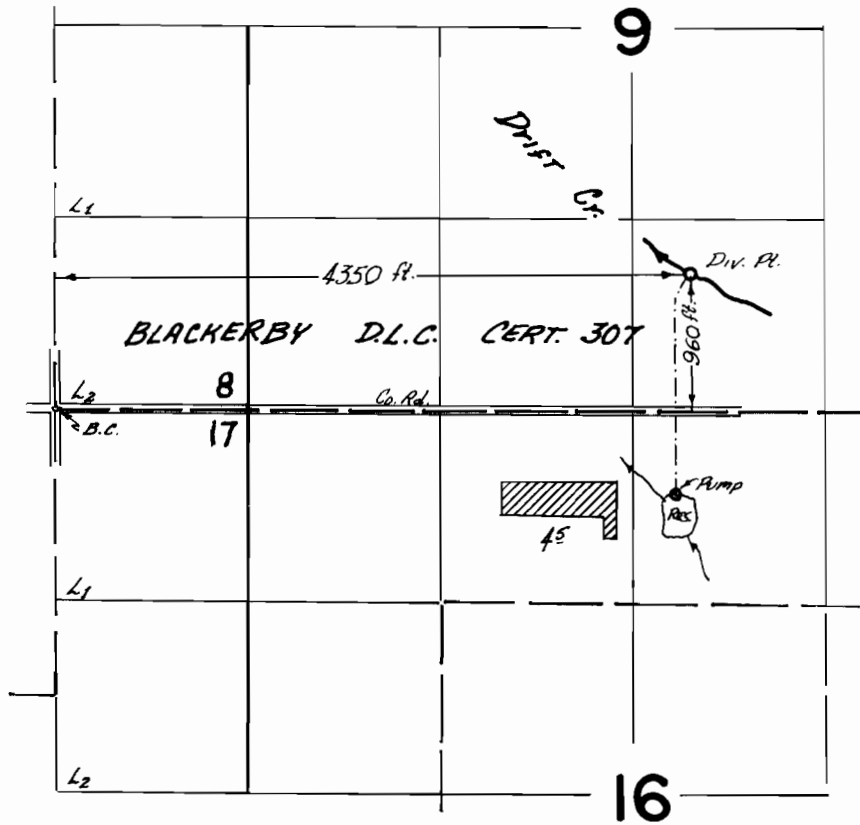

## FINAL PROOF SURVEY UNDER

TRANSFER 4-83

Application No. .... Permit No. ....  
IN NAME OF

..... JEROME LEWIS GEHRING .....

Surveyed APRIL 26 1972, by R. G. MUCKEN.....