


T.2S. R.44E. W.M.

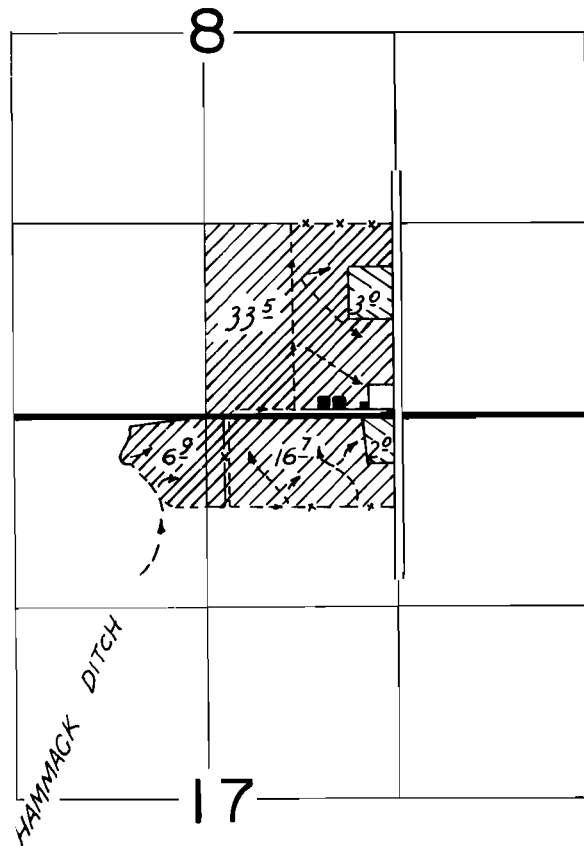

PRIMARY 

SUPPLEMENTAL 

FINAL PROOF SURVEY
UNDER

Transfer Application No.H.3... Permit No.
IN NAME OF

.....*Oscar L. Wingard*.....

Surveyed *Aug. 3, 1966*, by *V. Garner*.....
Aug. 17, 1981 *V. Church*