
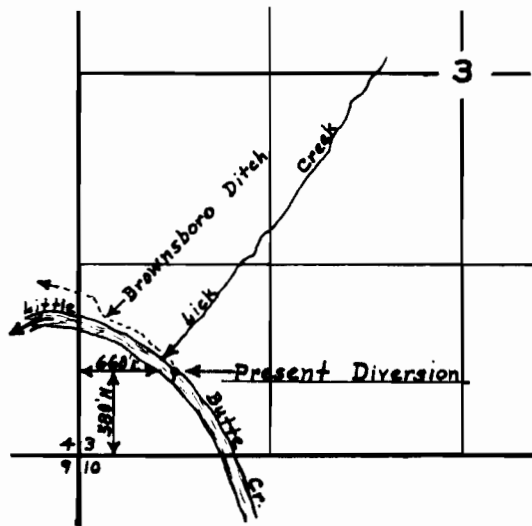


T. 36 S., R. 1 E., W. M.

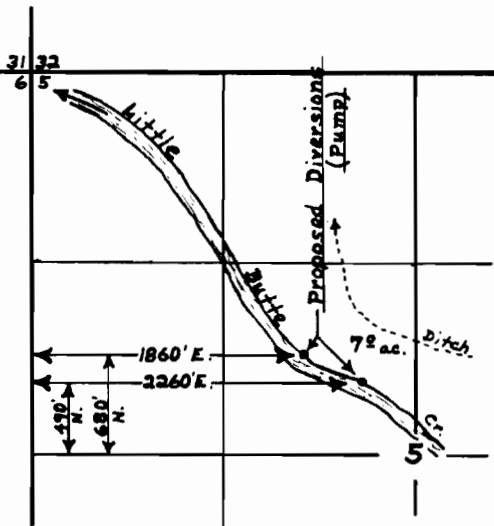

Transfer map for Bruce E. Hansen

March 7, 1961      Scale: 4" = 1 mile

Map prepared by David C. Hendrix