


T. 1 S. R. 12 & 13 E. W.M.

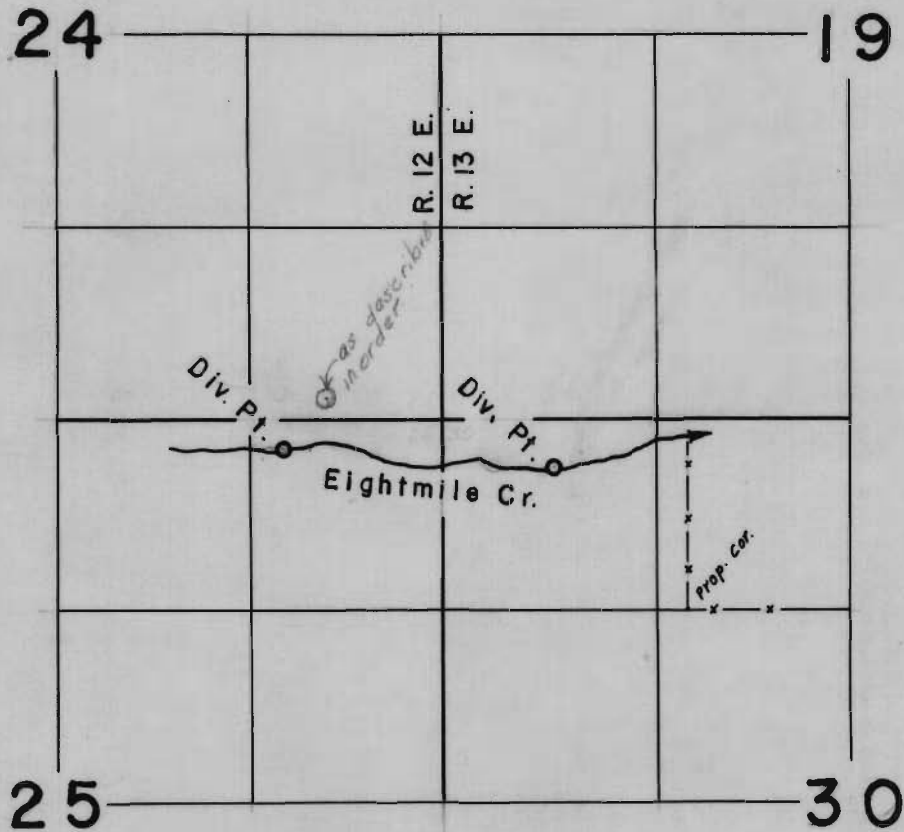

FINAL PROOF SURVEY
UNDER

RECEIVED
DEC 14 1962
STATE ENGINEER
SALEM, OREGON

Application Transfer No. H-121b.
IN NAME OF

C. R. HAUSE

Surveyed April 11, 1962, by *P. W. Johnson*