


T. 1 S. R. 13 E. W.M.

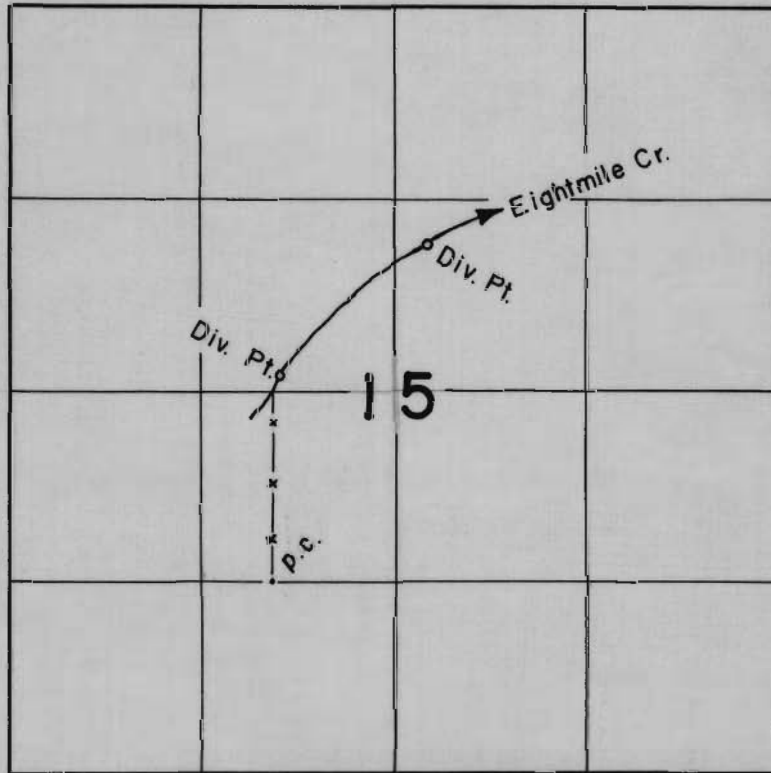

FINAL PROOF SURVEY
UNDER

Application Transfer No. H-123 to
IN NAME OF

GEORGE HASTINGS

Surveyed April 4, 1962, by *L.W. Johnson*