


T.5&6N. R.35E. W.M.

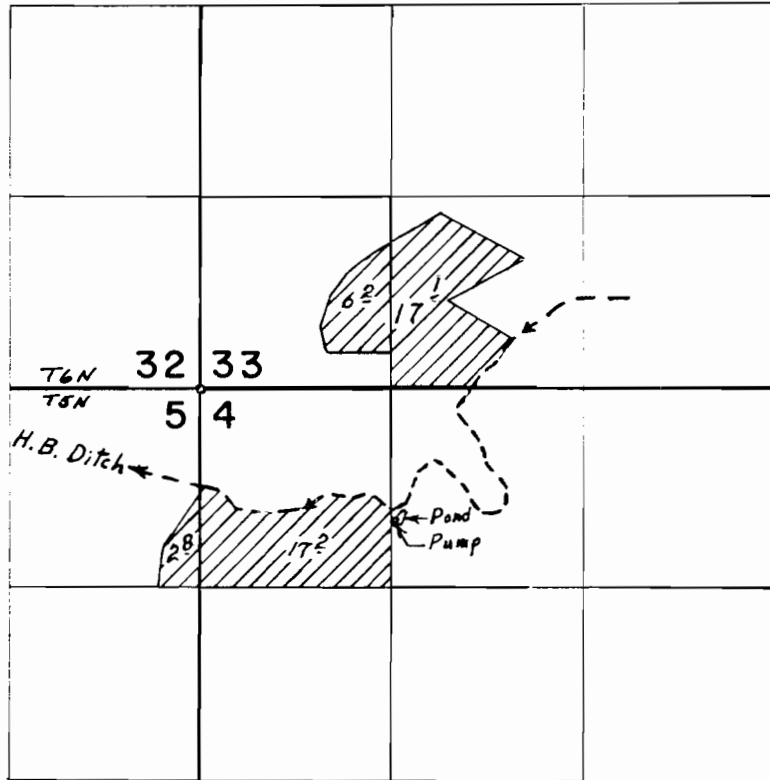

**FINAL PROOF SURVEY**  
UNDER

Application No. .... Transfer Permit No. H-131

IN NAME OF

C. H. HARRIS

Surveyed May 13, 1971, by Greg Baca