


# T.14S.R.12E.W.M.

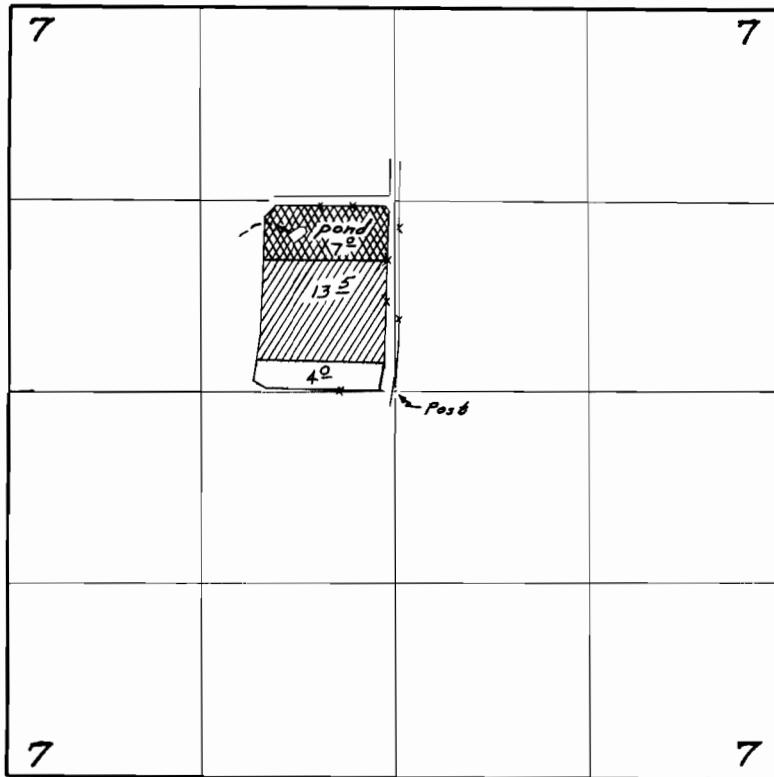

TR. H-137



TR. H-145

## FINAL PROOF SURVEY UNDER

*Transfers H-137 & H-145*

Application No. .... Permit No. ....

IN NAME OF

..... PRIDAY B. HOLMES .....

Surveyed *Sept. 1, 1966*, by *W.J. Ruppert*