


T. 3 S. R. 39 E. W. M.

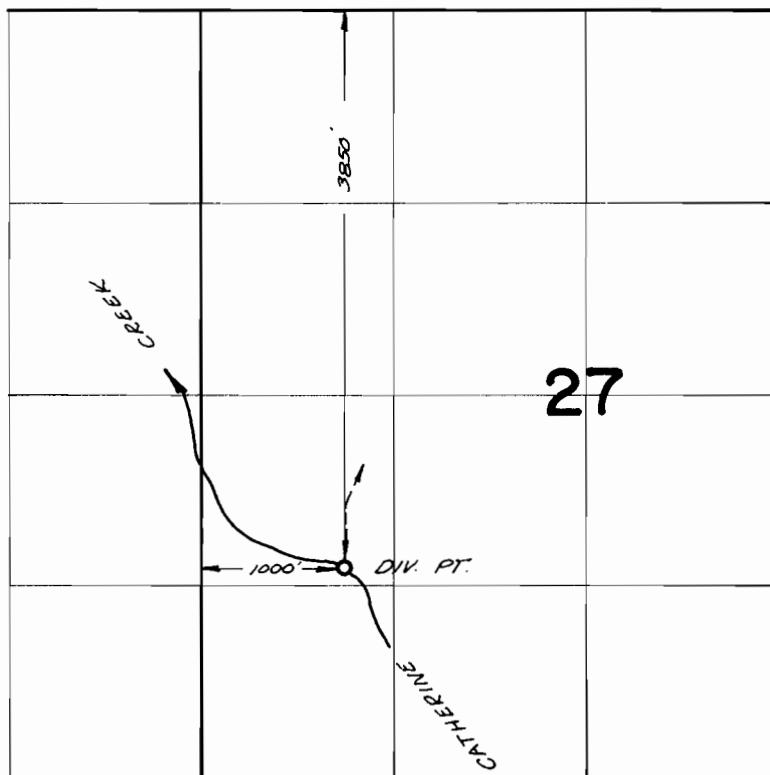

FINAL PROOF SURVEY
UNDER

TRANSFER H-146
Application No. _____ Permit No. _____
IN NAME OF

_____ MABLE HUTCHISON _____

Surveyed Aug. 24, 1968, by V. Garner _____